


Section 2 Township 35 Range 41W

Well No. #1 Brown (D)

Company Cities Service Oil

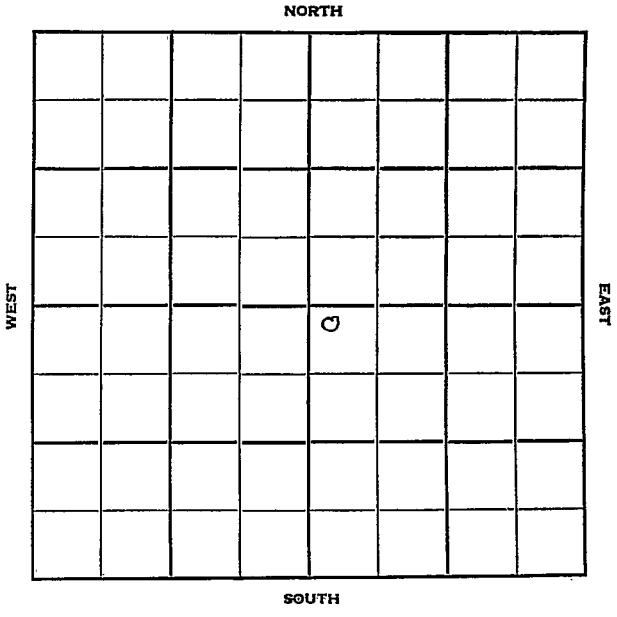

Morton

KANSAS

Sec. 2 Twp. 35 R. 41W

Well No. #1 Brown (D) Farm

Cities Service Oil Company

Barbour - Contr. Contractor


100' Ft. from N. Line

Ft. from S. Line

Ft. from E. Line

100' Ft. from W. Line

NW SE

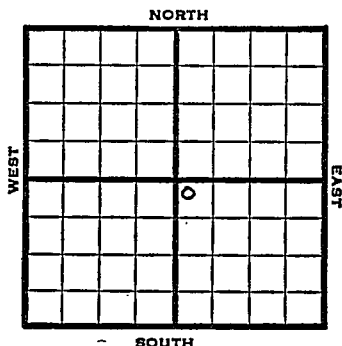

1952

Elev. 3458' REPORT

2/27

Spud 2-24-52
8" @ 400
WOC

3/5

Trying to regain cir at 1970'

3/12

TD 2500 5" @ 2499
Her 2368 Up Krider 2394
Law Krider 2412 Winfield 2452
DP to 2478 20/2473-77
80/2452-68 40/2424-32
40/2412-20 70/2394-2410

3/19

22,000-A

3/25

No report


4/1

4/9

"
Spud 2-24-52
Gas Well TD 2500
8" @ 400 5" @ 2499
TD 2500
Her. 2368 Kri 2394 Win 2452
DO to 2478 20/2473-77 80/2452-68
40/2424-32 40/2412-20 70/2394-2410
16,000 A Comp. 6,710,000 gas

COMPLETED

County **Morton** State **Kansas**
 Sec. **2** (Blk.) **35** (Sur.) **41W** Map No.
 Operator **Cities Service Oil**
 Well No. **1** Farm **Brown (D)**
 Elev. Location **NW SE**

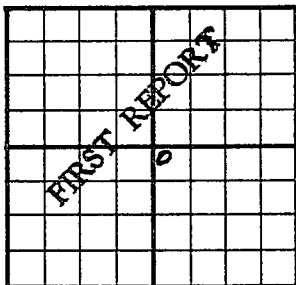

100 Ft. From **N** Line **SE**
100 Ft. From **W** Line Quarter

Ist. Report **FEB 27 1952**

Completion

Remarks

Barbour - Contr.


Spudding Date **2-24-52**

Drlg. Data

8" @ 400 W.O.C.

J. G. McGEHEE

County Morton State Kansas
 Sec. 2 (Blk. Twp.) 35 (Sur. Rge.) 41W Map No. _____
 Operator Cities Service Oil
 Well No. 1 Farm Brown "D"
 Elev. 3458 Location NW SE

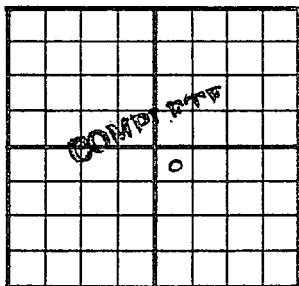

100 Ft. From N Line SE
 100 Ft. From W Line Quarter

1st. Report _____

Completion APR 9 1952

Remarks _____

Barbour - Contr.

Spudding Date 2-24-52

Drilg. Data Gas well TD 2500

8" @ 400 5" @ 2499 TD 2500

Her. 2368 Kri. 2394 Win. 2452

DO to 2478 20/ 2473-77 80/ 2452-68

40/ 2424-32 40/ 2412-20 70/ 2394-2410

16000 A Comp. 6,710,000 gas

J. G. McGEHEE