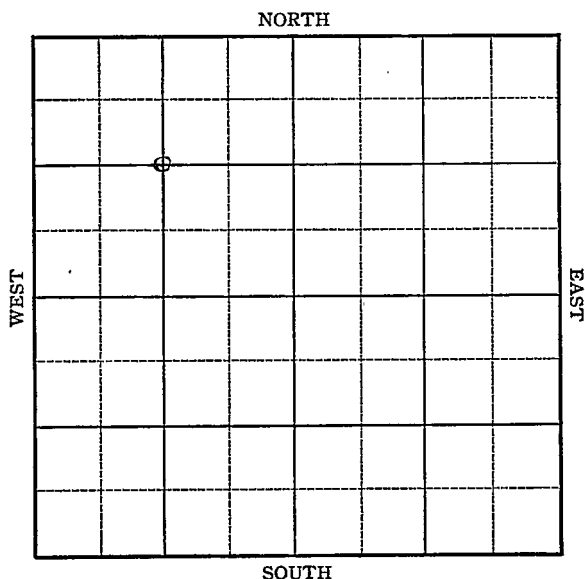



Stevena

KANSAS

Section 2 Township 35 Range 38 -WWell No. #1 MitchellCompany United Prod.

Sec. 2 Twp. 35 R. 38-WWell No. #1 Mitchell FarmUnited Prod. Company1320 Ft. from N. Line Ft. from S. Line Ft. from E. Line1320 Ft. from W. Line

Elev. 3281

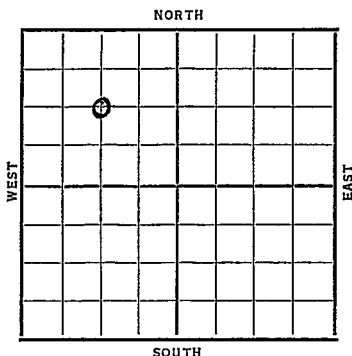

Date

REPORT

1937

9/29

R U R

10/8

Drlg. 1450'.

10/15

10" @ 610'. 7" @ 2570'.

S.G. WOC.

10/22

" "

10/29

" "

11/5

Drlg. 2745'.

11/10

7" @ 2570'.

Sand ?

T.D. 2840'.

5½ M gas.

COMPLETED

Stevens KANSAS

Map No. MM Sec. 2 Twp. 35 R. 38WWell No. 1-MitchellUnited Prod Company

Contractor

FIRST REPORT
C NW

SECTION PLAT

1320 Ft. from N. Line

_____ Ft. from S. Line

_____ Ft. from E. Line

1320 Ft. from W. Line

Location _____

Rig up _____

Drilling and Remarks:

RUR

RECORD

Cased _____ in., _____ ft.

Sand _____

Gas _____

Oil _____

Total Depth _____

PRODUCTION

1st 24 hrs. Nat. _____

1st 24 hrs. after shot _____

Gas _____ Cu. Ft.

Dry Hole _____

Abandoned _____

Date

SEP 29 1937 19 H. D. Hatfield Scout

Stevens

KANSAS

Map No. _____ Sec. 2 Twp. 35 R. 38WWell No. 1 Mitchell

United Production

Company

COMPLETED

Contractor

C NW


1320 Ft. from N. Line

_____ Ft. from S. Line

_____ Ft. from E. Line

1320 Ft. from W. Line

SECTION PLAT

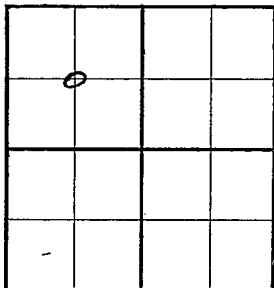

Location _____

Rig up _____

Drilling and Remarks:

5 1/2 M gas

RECORD

Cased 7 in., 2570 ft.Sand ?

Gas _____

Oil _____

Total Depth 2840

PRODUCTION

1st 24 hrs. Nat. _____

1st 24 hrs. after shot _____

Gas _____ Cu. Ft.

Dry Hole _____

Abandoned _____

Date

NOV 10 1937 19 H. D. Hatfield Scout