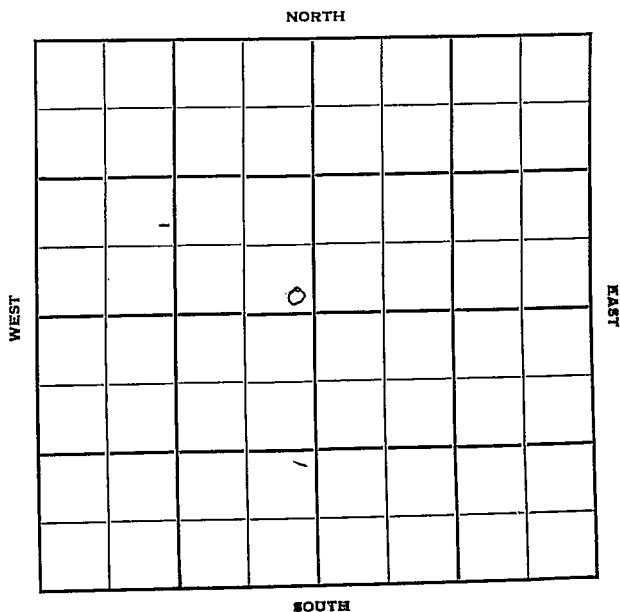


Section 2 Township 35 Range 35-WWell No. #1 MahoneyCompany Plains Natural Gas

Stevens

KANSAS

Sec. 2 Twp. 35 R. 35W

Well No. #1 Mahoney Farm

Plains Natural Gas Company

Hugoton Pool Contractor


Ft. from N. Line

200' Ft. from S. Line

200' Ft. from E. Line

Ft. from W. Line

SE SE NW

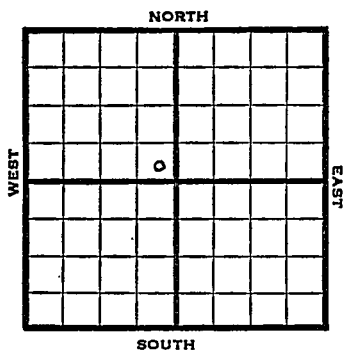

1950 Elev. 2967' REPORT

Location

Gas Well TD 2801'

10" @ 686' 7" @ 2787'

Hol. 2592' Her 2657'

Krider 2684'

Win. 2771'

30/2755-60 210/2717-52

60/2700-10 60/2685-95

72/2664-76 30/2657-62

60/2771-81

18,000 total acid

Comp. 2,794,000 gas

COMPLETED

Kansas

Hugoton Pool

Map No. _____ Sec. 2 Twp. 35 R. 35WWell No. 1 Mahoney

_____ Plains Natural Gas _____ Company

_____ Contractor


SE SE NW

SECTION PLAT

_____ Ft. from N. Line

200 Ft. from S. Line200 Ft. from E. Line

_____ Ft. from W. Line

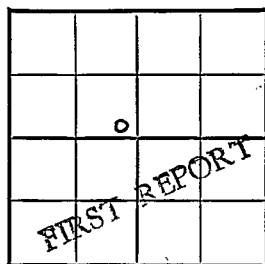

Stevens County /

Location X

Rig up _____

Drilling and Remarks:

RECORD

Cased _____ in., _____ ft.

Sand _____

Gas _____

Oil _____

Total Depth _____

PRODUCTION

1st 24 hrs. Nat. _____

1st 24 hrs. after shot _____

Gas _____ Cu. Ft.


Dry Hole _____

Abandoned _____

Date

JUL 5 1950. 19J. E. TYRA Scout

County Stevens State Kansas
 Sec. 2 (Blk. Twp.) 3 5 (Sur. Rge.) 3 5W Map No. _____
 Operator Plains Natural Gas
 Well No. 1 Farm Mahoney
 Elev. 2967 Location SE SE NW

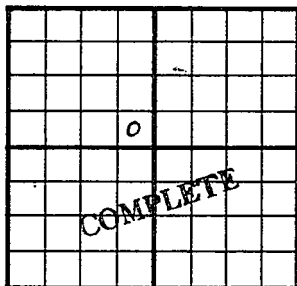

200 Ft. From S Line NW
200 Ft. From E Line Quarter

1st. Report

Completion SEP 20 1950

Remarks

Hugoton Pool

Spudding Date

Drlg. Data Gas well TD 2801

10" @ 686 7" @ 2787 TD 2801

Hol. 2592 Her. 2657 Krider 2684

Win. 2771 30/ 2755-60 210/ 2717-52

60/ 2700-10 60/ 2685-95 72/ 2664-76

30/ 2657-62 60/ 2771-81 18000 total acid

Comp. 2,794,000 gas

J. E. TYRA