

Stevens


FORM 51 IOM 12-46 PETROL

KANSAS

Section 2 Township 35 Range 36W

Well No. 1 Salley

Company Northern Natural Gas

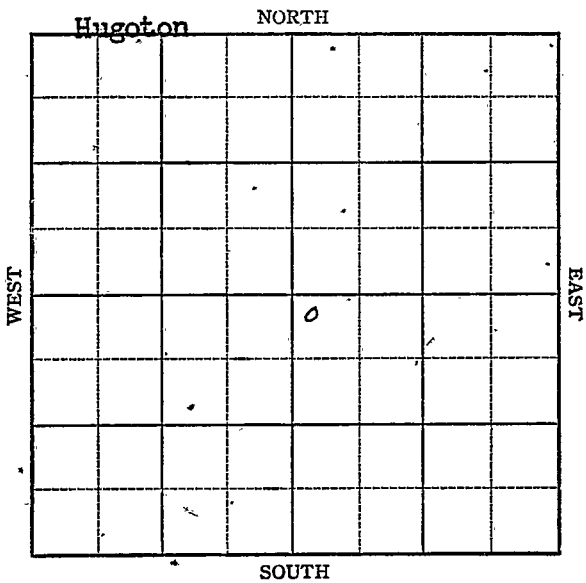

KANSAS

Stevens county

Sec. 2 Twp. 35 R. 36W

Well No. 1 Salley Farm

Northern Natural Gas Company

Hugoton Pool

100


Ft. from N. Line

Ft. from S. Line

Ft. from E. Line

100

Ft. from W. Line

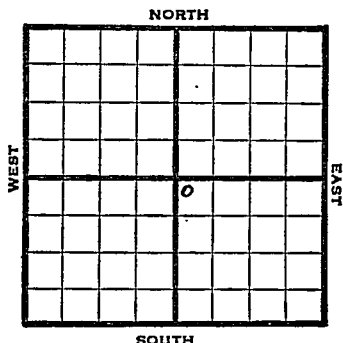

NW SE

1947 Elev. 3028' REPORT

5/7 Drlg. 585'.

5/13 10" @ 728'
TD 2623'
7" @ 2612'
RUST

5/20 " "

5/27 " "

6/3 Drlg. 2700'

6/10 TD 2812'
205' of 5" Perf. liner @ 2812'
15000 Acid.

6/18 8" @ 2612'
205' of 5" Perf. liner @ 2822'
15000 Acid
26,363,000 Gas
419# R. Pr
TD 2812'

COMPLETED

Map No. _____ Sec. 2 Twp. 35 R. 36W

Well No. 1 Salley

Northern Natural Gas Company

FIRST REPORT

Contractor _____

NW SE


SECTION PLAT

100 Ft. from N. Line

_____ Ft. from S. Line

_____ Ft. from E. Line

100 Ft. from W. Line

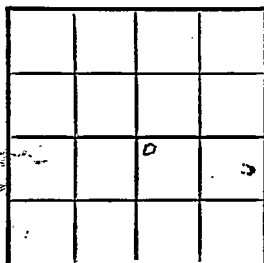

Stevens County

Location _____

Rig up _____

Drilling and Remarks:

drlg. 585

RECORD

Cased _____ in _____ ft.

Sand _____

Gas _____

Oil _____

Total Depth _____

PRODUCTION

1st 24 hrs. Nat. _____

1st 24 hrs. after shot _____

Gas _____ Cu. Ft.

Dry Hole _____

Abandoned _____

Date

MAY 14 1947 19

S. J. LEWIS

Scout

Map No. 0 Sec. 2 Twp. 35 R. 36W

Well No. 1 Salley

Northern Natural Gas Company

COMPLETE

Contractor

NW SE

E 13028

SECTION PLAT

100 Ft. from N. Line

 Ft. from S. Line

1 Ft. from E. Line

100 Ft. from W. Line

		0	

Stevens County

Location

Rig up

Drilling and Remarks:

8" @ 26 1/2

205' of 5" Prof lined

@ 28 1/2

15000 ac acid

26,360,000 Gas

419 1/2 R/L

RECORD

Cased in., ft.

Band

Gas

Oil

Total Depth 2812

PRODUCTION

1st 24 hrs. Nat.

1st 24 hrs. after shot

Gas Cu. Ft.

Dry Hole

Abandoned

Date

JUN 1 8 1947

19

S. J. LEWIS

Scout