

DX 78-1


Seward

KANSAS

Section 2 Township 35 Range 32 W

Well No. # 2 Light Est. "C"

Company Huber Corp.

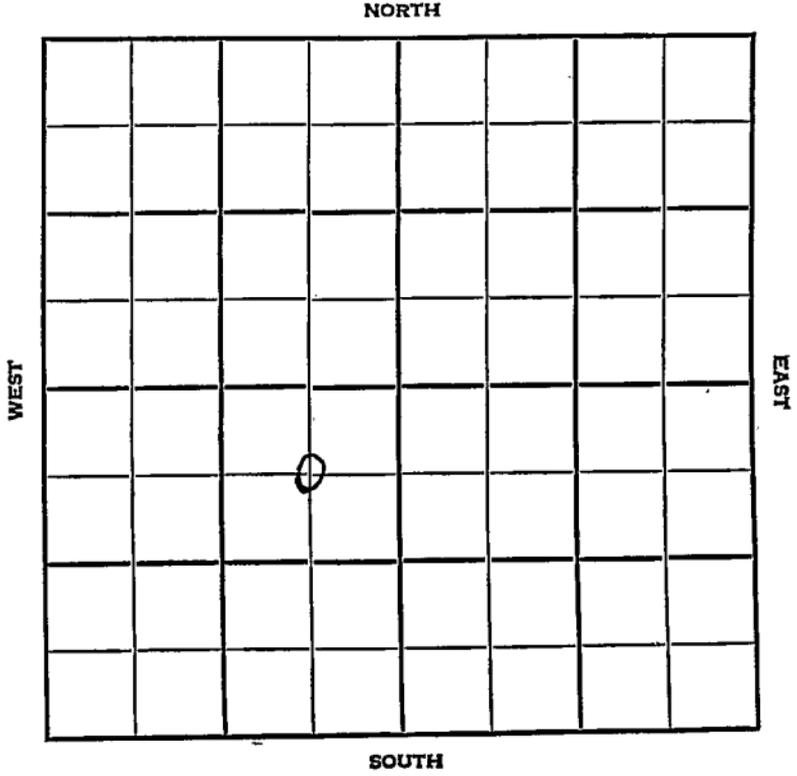

Seward

KANSAS

|      |      |      |
|------|------|------|
| SEC. | TWP. | R.   |
| 2    | 35   | 32 W |

WELL NO. \_\_\_\_\_

COMPANY # 2 Light Est. "G" FARM

CONTRACTOR Huber Corp.

Co. tools


Liberal Light Pool

660 \_\_\_\_\_ Ft. from N. Line

\_\_\_\_\_ Ft. from S. Line

660 \_\_\_\_\_ Ft. from E. Line

\_\_\_\_\_ Ft. from W. Line

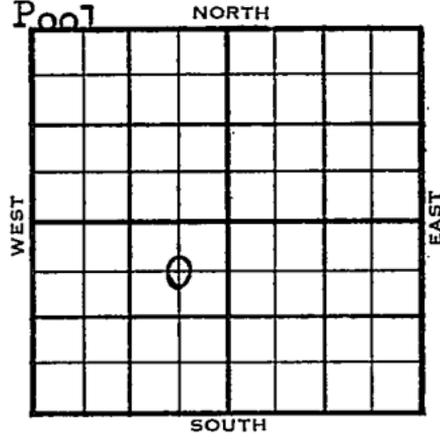

C NE SW

|      |                    |        |
|------|--------------------|--------|
| 1955 | ELEVATION<br>2743' | REPORT |
|------|--------------------|--------|

1/26 Location

3/9 Spud 2-6-55 D & A TD 6265'  
 8" @ 1600 Morrow 5906'  
 DST 5906-6001 failed.  
 DST 5905-6001, open 25 min, no rec.  
 600# Miss 6180' TD 6265'  
 D & A

**ABANDONED**



