FORM 51 25M 3-49 PETROL


KANSAS

Seward

Section 2 Township 35 Range 32W

Well No. #1 Light Est. "C"

Company Huber Corp.

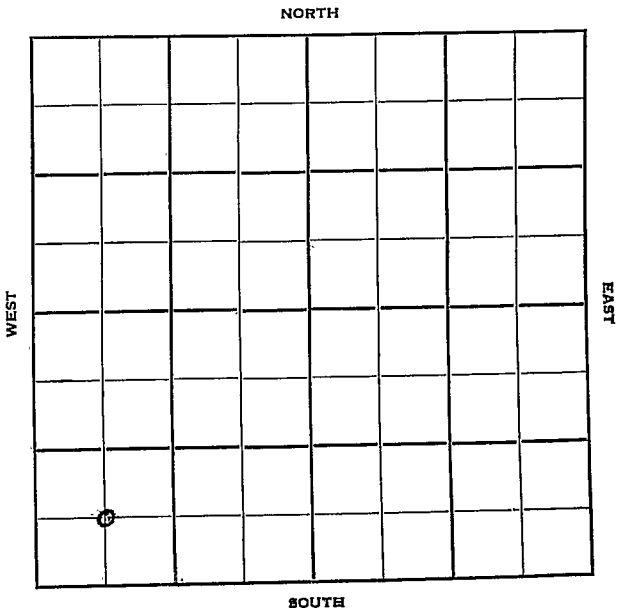

FORM 252-B

KANSAS

Seward

Sec. 2 Twp. 35 R. 32W

Well No. #1 Light Est. "C" Farm

Huber Corporation Company

Contractor


Ft. from N. Line

660 Ft. from S. Line

Ft. from E. Line

660 Ft. from W. Line

C SW SW

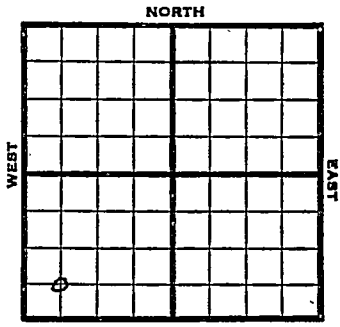

(Deep Test)

1953	Elev. 2757' REPORT
3/18	Location
3/26	13" @ 624 Drlg. 806'
4/2	Drlg 2407'
4/9	Drlg. 3635'
4/16	Drlg 4965'
4/23	Drlg 5656'
4/30	N.R.
5/7	NR
5/20	Spud 3-22-53 Gas Well TD 6327' 13" @ 624' DST 5386-5500 failed DST 5402-5500 opn 1 hr, rec 180' mud 0# DST 5500-5600 failed. DST 5492-5600 failed. DST 5970-90 opn 22 min, spray oil in 7 min, rec 3,130,000 gas in 2 min. 180' free oil 1785# TD 6327' Lans 4430, Marm 5395, Morrow 5930, Chester 6190, 5" @ 6040' 24/ 5965-68 F/ 7 bo 1 hr. 4,640,000 gas. F/ 11 bo 1 hr. 4,700,000 gas.

OVER

1953

Information brought forward.

5/20 F/ 14 bo 1 hr. 4,600,000 gas.
16/ 5961-65 F/ 74 bo 10,448,000 gas 8 hr.
Comp. 21,687,000 gas 159 bopd.

COMPLETED

FORM 275 FOR SALE BY KANSAS BLUE PRINT CO.


County Seward State Kansas

Sec. 2 (Blk. Twp.) 35 (Sur. Rge.) 32W Map No.

Operator Huber Corp.

Well No. 1 Farm Light Est. "C"

Elev. Location C SW SW

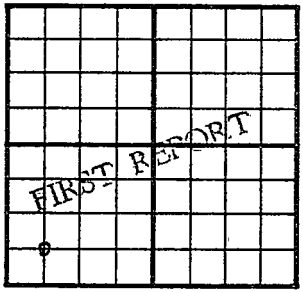

660 Ft. From S Line SW

660 Ft. From W Line Quarter

1st. Report MAR 1 8 1953

Completion


Remarks Deep test

Spudding Date

Drlg. Data

Location

J. G. McGEHEE

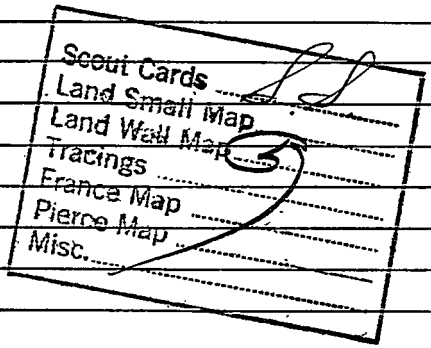

MAR 20 1953

Drlg. Data

FORM 275 FOR SALE BY KANSAS BLUE PRINT CO.


County Seward State Kansas

Sec. 2 (Blk. Twp.) 35 (Sur. Rge.) 32W Map No.

Operator Huber Corp.

Well No. 1 Farm Light Est. "C"

Elev. 2757 Location C SW SW

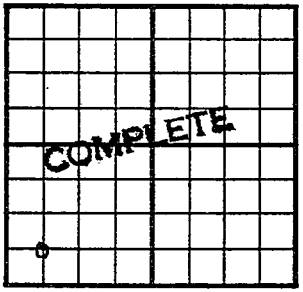

660 Ft. From S Line SW

660 Ft. From W Line Quarter

1st. Report

Completion MAY 20 1953

Remarks

Spudding Date 3-22-53

Drlg. Data Gas well TD 6327

13" @ 624 DST 5386-5500 failed

DST 5402-5500 open 1 hr. Rec. 180' mud

0# DST 5500-5600 failed DST 5492-5600

failed DST 5970-90 open 22 min.

Spray oil in 7 min. rec. 3,130,000 gas in

2 min. 180' free oil 1785#

TD 6327 Lans. 4430 Marm. 5395

Morrow 5930 Chester 6190 5" @ 6040

24/ 5965-68 F/ 7 bo 1 hr. 4,640,000 gas


F/ 11 bo 1 hr. 4,700,000 gas

F/ 14 bo 1 hr. 4,600,000 gas

16/ 5961-65 F/ 74 bo 10,448,000 gas 8 hr.

Comp. 21,687,000 gas 159 bopd

J. G. McGEHEE

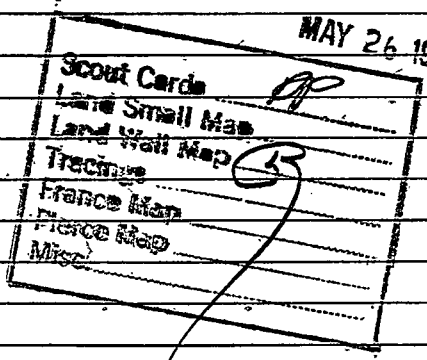
Scout Cards
Land Small Map
Land Wall Map
Trecmus
France Map
Fierce Map
Misc

Drlg. Data