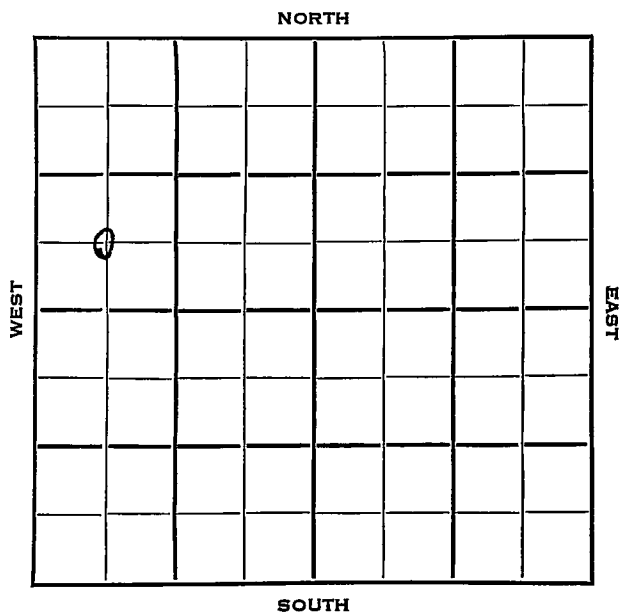


Seward

KANSAS


Section 2 Township 35 Range 32 WWell No. # 1 WhiteCompany Huber et al

Seward

KANSAS

Sec. 2 Twp. 35 R. 32 WWell No. # 1 White FarmHuber et al CompanyHuber Contractor Ft. from N. Line660 Ft. from S. Line Ft. from E. Line660 Ft. from W. Line

C SW NW

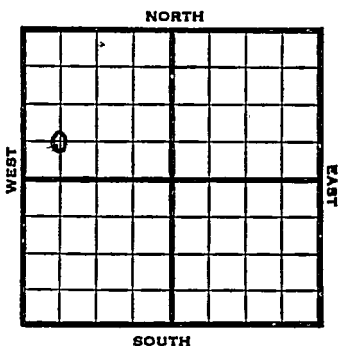

1953

Elv. 2749'

REPORT

6/24

Location

7/1

NR

7/8

RUR

7/22

13" @ 625'

9" @ 2396'

Drlg 3622'

7/29

Drlg. 4961'

8/5

Lans 4450

DST 5065-5110 1½ hrs 600' SW 1750#

Marm 5360

Drlg 5670'

8/12

Morrow 5888, Chester 6166

RTD 6292 Schl.

5" @ 6013'

8/19

N.R.

9/9

Spud 7-8-53

Gas Well

TD 6292'

13" @ 625'

9" @ 2396'

DST 5065-5110' opn 1 1/3 hr, rec 600' sw, 1750#

Lans 4450, Marm 5360, Morrow 5888,

OVER

1953

Information brought forward.

9/9

Chester 6166'

TD 6292'

5" @ 6013'

31/ 5930-39 SP 5904 7,220,000 gas
3 hr.

40/ 5920-30 $8\frac{1}{2}$ mcfg.

Comp. 12,012,000 gas 90 bbl dist
per day.

COMPLETED

County Seward State Kansas
 Sec. 2 (Blk. 35 (Sur. 32W Map No.
 (Twp.) (Rge.)
 Operator Huber et al.
 Well No. 1 Farm White
 Elev. Location G SW NW

FIRST REPORT

660 Ft. From S Line NW
660 Ft. From W Line Quarter
 1st. Report JUN - 24 1953
 Completion
 Remarks
Huber - Contr.
 Spudding Date

Drilg. Data


Location

J. G. McGEHEE

Scout Cards	777
Land Small Map	
Land Wall Map	3
Tracings	
France Map	
Pierce Map	
Misc.	

JUN 26 1953

Orig. Data

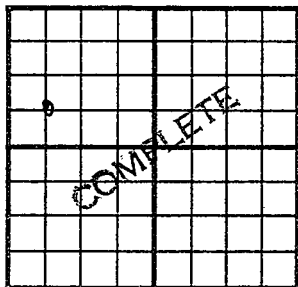County Seward State KansasSec. 2 (Blk. Twp.) 35 (Sur. Rge.) 3 2W Map No.Operator Huber et al.Well No. 1 Farm WhiteElev. 2749 Location C SW NW660 Ft. From S Line NW660 Ft. From W Line Quarter

1st. Report

Completion SEP 9 1953

Remarks

Huber - Contr.Spudding Date 7-8-53Drig. Data Gas well TD 629213" @ 625 9" @ 2396 DST 5065-5110open 1 1/3 hr. rec. 600' sw 1750#Lans. 4450 Marm. 5360 Morrow 5888Chester 6166 TD 6292 5" @ 601331/ 5930-39 SP 5904 7,220,000 gas 3 hr.40/ 5920-30 8 1/2 mcf/gComp. 12,042,000 gas 90 bbl. dist per day

SEP 15 1950

Scout Cards	
Lat. & Small Map	
Land Wall Map	 53
Tracings	
France Map	
Pierce Map	
Misc.	

Orig. Data