


Section 2 Township 35 Range 32WWell No. 1 Nellie "B"Company Phillips Petr. Co.

NORTH

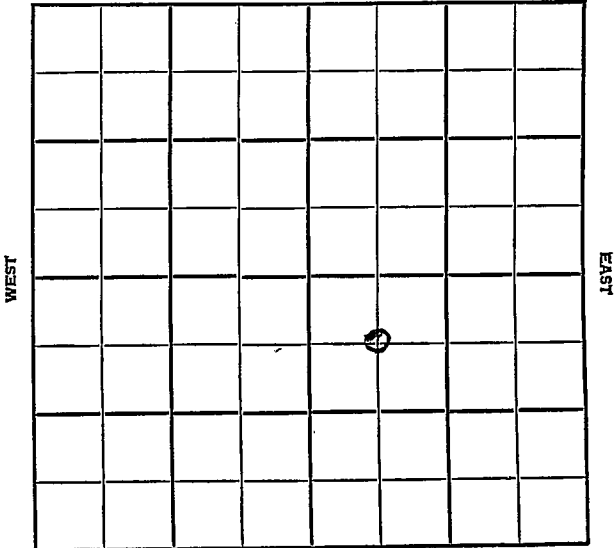

SOUTH

Seward KANSAS

SEC.	TWP.	R.
2	35	32W

WELL NO.

1 Nellie "B"

FARM

COMPANY

Phillips Petr. Co.

CONTRACTOR

Moran Tools


Wildcat

660 Ft. from N. Line

Ft. from S. Line

Ft. from E. Line

660 Ft. from W. Line

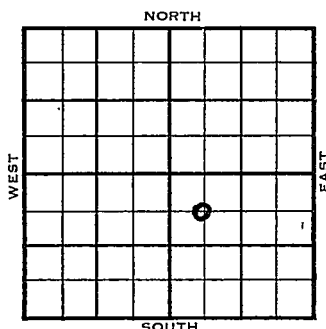

C NW SE


	ELEVATION	REPORT
1954	2752'	
9/15	Spud 9-5-54 13" @ 639' 8" @ 2400' Drilg. 3375'	Miss Test 6000'
10/20	Spud 9-5-54 Oil well TD 6305' 13" @ 639 8" @ 2400 Wabaunsee 3620' Tor. 4480' Lans 4602' Morrow 5978' DST 5979-90, failed. DST 5983-90 open 1½ hr gas in 16 min 648,000 CFG rec 38 BO 59 min. 0# TD 6305' 5" @ 6298 Shawnee 4029' Tor. 4475' Lans 4605' B KC 5260' Marm. 5306' Cherokee 5558' Morrow 5953' Morrow 5978' Miss 6206' TD 6305' CO F/154 BO 7 hr. Comp. 528 BOPD	
COMPLETED		

FABEN GILSTRAP

SEP 17 1954

Scout Cards	12
Land Small Map	
Land Wall Map	33
Tracings	
France Map	
Pierce Map	
Misc.	

Drig. Date

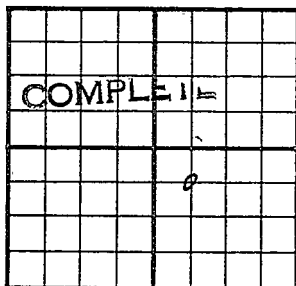County Seward State KansasSec. 2 (Blk.) 35 (Sur.) 32W Map No.Operator Phillips Pet.Well No. 1 Farm Nellie "B"Elev. 2752 Location C NW SE660 Ft. From N Line SE660 Ft. From W Line Quarter

1st. Report

Completion OCT 20 1954Remarks WildcatMoran - Contr.Spudding Date 9-5-54Drlg. Data Oil well TD 630513" @ 639 8" @ 2400 Wabaunsee 3620Tor. 4480 Lans. 4602 Morrow 5978DST 5979-90 failed DST 5983-90open 1½ hr. gas in 16 min. 648,000 cfgRec. 38 bo 59 min. 0# TD 63055" @ 6298 Shawnee 4029 Tor. 4475Lans. 4605 B KC 5260 Marm. 5306Cherokee 5558 Morrow 5953 Morrow 5978Miss. 6206 TD 6305 CO F/ 154 bo 7 hr.Comp. 528 bopd

FABIAN GILSTRAP

Scout Cards	MM
Land Small Map	
Land Wall Map	55
Tracings	
France Map	
Pierce Map	
Notes	

OCT 27 1954

Orig. Data