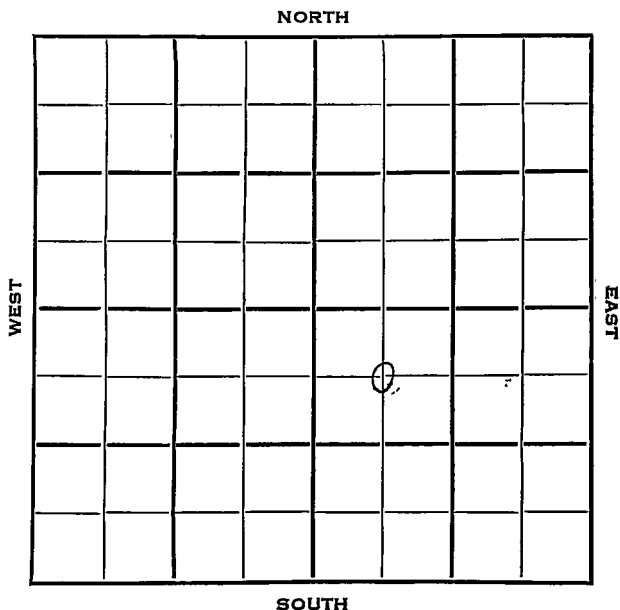


Section 2 Township 35 Range 32 WWell No. # 1 Nellie "B"Company Phillips Pet. & Panhandle Eastern

Seward KANSAS

SEC.	TWP.	R.
2	35	3 2W ✓

WELL NO.

1 Nellie "B"

FARM

COMPANY

Phillips Petr. & Panhandle Eastern

CONTRACTOR

Moran


Wildcat

660 Ft. from N. Line

Ft. from S. Line

Ft. from E. Line

660 Ft. from W. Line

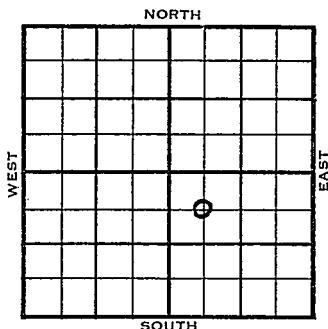

C NW SE

1953

ELEVATION

2752'

REPORT

12/2 Location

12/9 "

2/24 Abandoned Location

ABANDONED


County Seward State Kansas
 Sec. 2 (Blk. Twp.) 35 (Sur. Rge.) 32W Map No.
 Operator Phillips Pet. & Panhandle Eastern
 Well No. 1 Farm Nellie "B"
 Elev. _____ Location C NW SE

FIRST REPORT

660 Ft. From N Line SE
660 Ft. From W Line Quarter
 1st. Report DEC 2 1953
 Completion _____
 Remarks _____
Moran - Contr.
 Spudding Date _____

Drilg. Data Wildcat
Location

County Seward State Kansas
 Sec. 2 (Blk. 35 (Sur. 3 2W (Twp. Map No.
 Operator Phillips Pet. & Panhandle Eastern
 Well No. 1 Farm Nellie "B"
 Elev. 2752 Location C NW SE

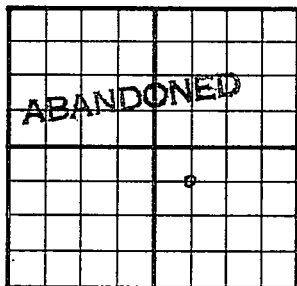

660 Ft. From N Line SE
660 Ft. From W Line Quarter
 1st. Report
 Completion FEB 24 1954
 Remarks Wildcat
Moran - Contr.
 Spudding Date

Drlg. Data

Abd. location