

DX 78-1


Seward

KANSAS

Section 2 Township 35 Range 32 W

Well No. # 2 Neff

Company Huber Corp. & United Prod.

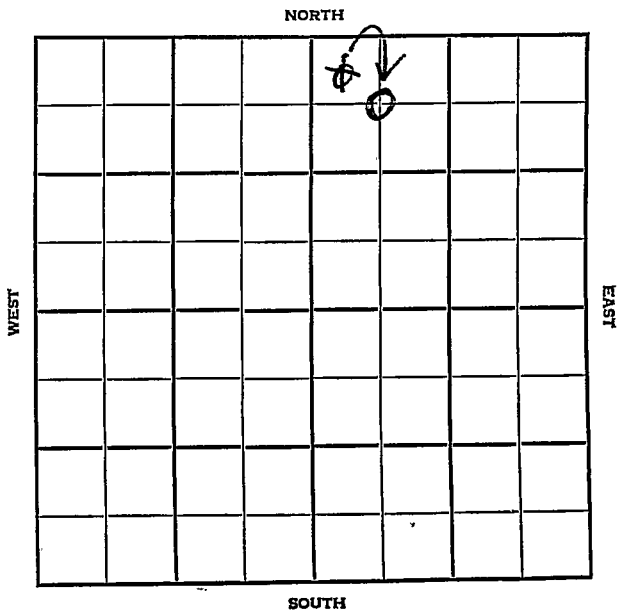

Seward.

KANSAS

SEC.	TWP.	R.
2	35	32W

WELL NO.

#2 Neff

FARM

COMPANY

Huber Corp. & United Production

CONTRACTOR

Co. Tools.

~~660~~
~~330~~

Liberal Light.

NORTH


Ft. from N. Line

Ft. from S. Line

Ft. from E. Line

~~660~~
~~330~~

Ft. from W. Line

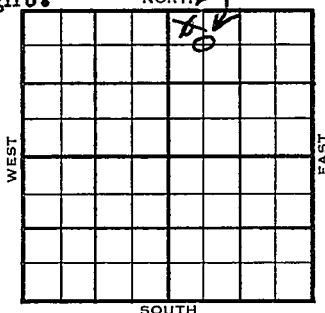
~~C~~
~~NW~~ NW NE

	ELEVATION	REPORT
1955	2738'	
1/5	Spud 12-31-54 13" @ 400' Dr1g. 1910'	
3/9	Spud 12-31-54 Gas well TD 6150' 13" @ 400 9-5/8" @ 2400 Marm. 5370 DST 5315-78 open 1 hr rec 240' SGCM 150' SGSWCM 1530# Morrow 5904' DST 5938-85 open 40 min, 6,800,000 CFG 1875#. DST 5960-6033, open 40 min, gas in 2 min, 3,250,000 CFG 11 min. 5,200,000 CFG 40 min, rec 45' GCM 1850#. TD 6150' DST 6048-6147 open 1 hr rec 91' SO & GCM 300# 7" @ 6145 LOG TOPS: Tor. 4440', Lans 4576', Marm. 5280', Morrow 5882', Chester 6082', CO to 6108' 120/6046-76 500 A 400,000 CFG- frac. 608,000 CFG 72/5977-95 5,100,000 CFG. Comp. 5,215,000 CFGPD	
COMPLETED		

SCOUT TICKET

DX-201

K 37826

SEC.

2

TWP.

35

R.

32W

WELL NO.

2 Neff

FARM

COMPANY

Huber & United Prod.

CONTRACTOR

CORRECTION


C NW NE

660 FT. FROM N. LINE

FT. FROM S. LINE

FT. FORM E. LINE

660 FT. FROM W. LINE

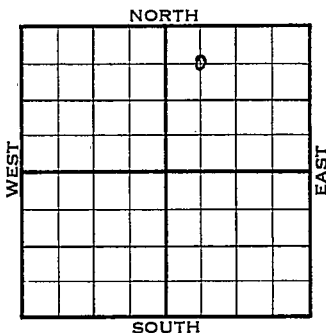

Seward County

☐

LOCATION

☐

RIG UP

DRILLING AND REMARKS:

Reported

NW NW NE

RECORD

CASED IN. FT.

SAND

GAS

OIL

TOTAL DEPTH

1ST 24 HRS. NAT.

1ST 24 HRS. AFTER SHOT

GAS CU. FT.

DRY HOLE

ABANDONED

PRODUCTION

DATE

JAN 1 2 1955

SCOUT

FABEN GILSTRAP

JAN 14 1955

Scout Cards	<i>m m</i>
Land Small Map	
Land Wall Map	<i>3</i>
Tracings	
France B p	
France Map	
ATOC	

County **Seward** State **Kansas**

Sec. 2 (Blk. Twp.) 35 (Sur. Rge.) 32W Map No.

Operator **Huber Corp. & United Production**

Well No. 2 Farm Neff

Elev.	Location	NW	NW	NE
-------	----------	----	----	----

0
See CS
~~FIRST REPORT~~

330 Ft. From N Line NE

330 Ft. From ^W Line Quarter

1st. Report IAN 5 1955

Completion 

Remarks


Co. tools

Spudding Date **12-31-54**

Drlg. Data Liberal Light


13" @ 400 drlg. 1910

FABEN GILSTRAP

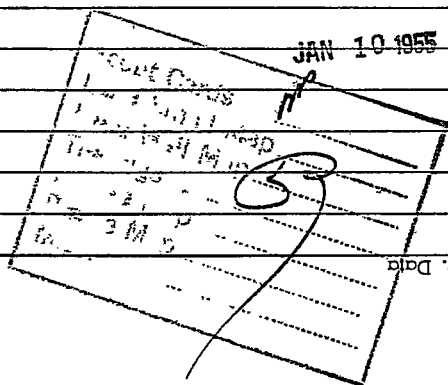

Drig. Data

County Seward State Kansas
 Sec. 2 (Blk.) 35 (Sur.) 32W Map No.
 Operator Huber Corp. & United Production
 Well No. 2 Farm Neff
 Elev. 2738 Location C NW NE

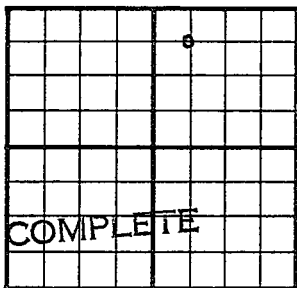

660 Ft. From N Line NE

660 Ft. From W Line Quarter

1st. Report

Completion MAR 9 1955

Remarks Liberal Light Pool
Co. tools

Spudding Date 12-31-54

Drlg. Data Gas well TD 6150

13" @ 400 9 5/8" @ 2400 Marm. 5370

DST 5315-78 open 1 hr. Rec. 240' sgcm

150' sgswcm 1530# Morrow 5904

DST 5938-85 open 40 min. 6,800,000 cfg

1875# DST 5960-6033 open 40 min.

gas in 2 min. 3,250,000 cfg 11 min.

5,200,000 cfg 40 min. Rec. 45' gcm

1850# TD 6150 DST 6048-6147 open 1 hr

Rec. 91' so & gcm 300# 7" @ 6145

LOG TOPS:

Tor. 4440 Lans. 4576 Marm. 5280

Morrow 5882 Chester 6082 CO to 6108

120/ 6046-76 500 A 400,000 cfg

frac 608,000 cfg 72/ 5977-95

FABEN GILSTRAP

OVER

Scout Card	7777
Land Sheet	
Land Sheet	
Frederick	
France Map	
Photo Map	
Notes	

MAR 15 1955

5,100,000 cft Comp. 5,215,000 cft pd

Drig. Data