

Meade


KANSAS

SECTION 2 TOWNSHIP 35S RANGE 30W

WELL NO. #1 A.W. Adams

COMPANY United Producing

NORTH C SW/4

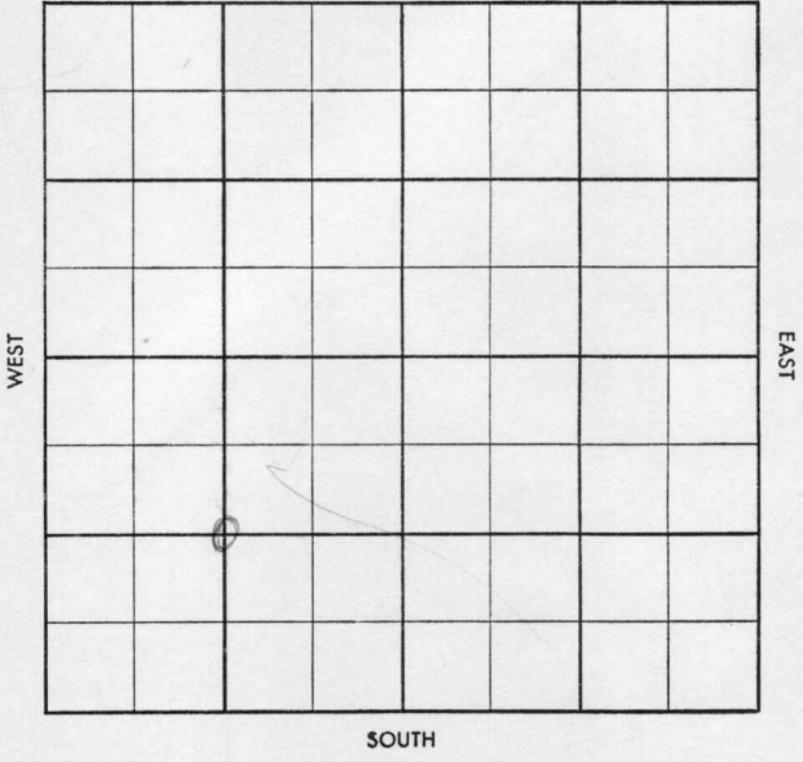


Telephone No. _____
✓
B

County Meade Elev. _____
Sec. 2 Twp. 35 Rge. 30W
Company United Producing
Farm Name A. W. Adams No. 1

TOPS	DEPTH	LOG	DATUM
Anh.			
Tp.			
H.			
Tr.			
Dg.			
B.L.			
L.			
K.C.			
B.K.C.			
Ce.			
C.			
M.			
M.			
K.			
Mz.			
Mq.			
V.			
S.			
S.			
A.			
R.			
Pf.			
G.			
T.D.			

Loc. in Sec. C SW/4
Geol. _____
Contr. _____
Rind Drlg.
Pool _____
Adams Ranch

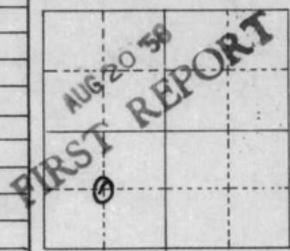

Date Comm. 8-16-58
B3" @ 521 w/500, WOC

Co.
Lse.
No.
Sec.
T.
R.

Twp. _____ Pool _____

Co. _____ Facet _____

5-513-B

County Meade Elev. 24590F 2492
 Sec. 2 Twp. 35 Rge. 30W
 Company United Producing
 Farm Name A. W. Adams No. 1

TOPS	DEPTH	LOG	DATUM
Anh.			
Tp.			
H.			
Tr.	4358	4370	
Dg. <u>check</u>	4984	4982	
B.L. <u>Lsg</u>		4478	
L. <u>p d m</u>	5175	5165	
<u>12' g m</u>	5640		
B.K.C. <u>low</u>		5267	
Ce. <u>2</u>		5384	
C. <u>mor</u>		5735	
M. <u>mor sd</u>		5852 - 60	
M. <u>crater</u>		5870	
K. <u>crater sd</u>		6039 - 43	
Mz. <u>sd</u>		6070 - 90	
Mq. <u>5' Ben</u>		6127	
V.			
S.			
S.			
A.			
R.			
Pf.			
G.			
T.D.	6235	6240	

Loc. in Sec. C SW/4
 Geol. _____
 Contr. _____
 Line Drlg. _____
 Pool Adams Ranch

ABANDONED
 0
 SEP 17 '88

Date Comm. 8-16-58
E3" w 521 w/500, 100' AUG 27 '58 8" 2593/50.
Ø 2930 p 3 '58 Ø 5108 SEP 10 '58 DST
5294 - 5404 60" 100 sqcm
BHP 1425/30 5970-110 DST 5640
-52 60" 5' m all P zero
Ø SEP 17 '58 DST 5752 - 69 60"
10' sqcm FP 15-15 BHP 125/30"
DST 5834 - 57 60" g/10" ga 44
mfl/15 TSTM 15" 20 gcm FP 15-15
F BHP 1590/30

DST 6212-35 60" 15' M FP30-
BHP 480/30" DST (SD) 5130-521
150' gir 90' gear 180 06 gr 650
M 950 508 gear FP/45-6
BHP 1635/30"

D&A