

Clark


KANSAS

SECTION 2 TOWNSHIP 35S RANGE 25W

WELL NO. #1 Locke-Theis "B"

COMPANY Tennessee Gas (75%) Graham Michaelis (25%)

NORTH C SE NW

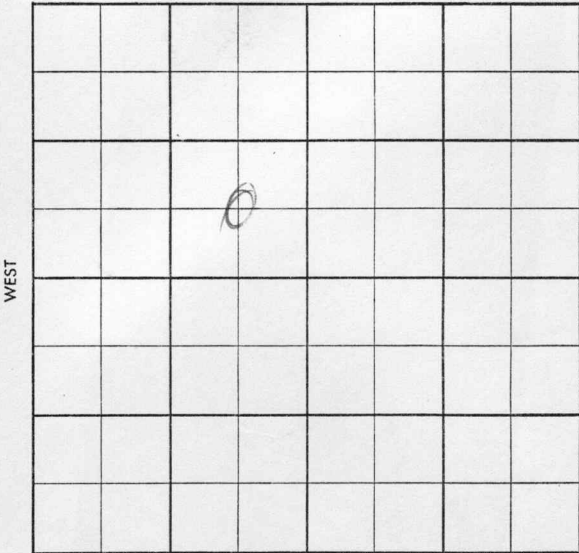

WEST

EAST

SOUTH

24

S-513-B

County Clark Elev. _____
 Sec. 2 Twp. 35 Rge. 25W
 Company Tennessee Gas 75%, Graham Michaelis
(25%)
 Farm Name Locke-Theis "B" No. 1

Co.
Lse.
No.
Sec.
T.
R.

TOPS	DEPTH	LOG	DATUM
Anh.			
Tp.			
H.			
Tr.			
Dg.			
B.L.			
L.			
K.C.			
B.K.C.			
Ce.			
C.			
M.			
M.			
K.			
Mz.			
Mq.			
V.			
S.			
S.			
A.			
R.			
Pf.			
G.			
T.D.			

Loc. in Sec. _____
C SE NW
 Geol. _____
 Contr. _____
G-M #4
 Pool _____
McKinney

FIRST REPORT
 FEB 5 1958

Date Comm. 1/30/58 (Shell - FO)
13" @ 100 w/250, 8" @ 600 w/235, Drlg. 2328

S-513-B

County Clark Elev. 1989 OF 1992 AB
 Sec. 2 Twp. 35 Rge. 25W
 Company Tennessee Gas 75%, Graham Michaelis (25%)
 Farm Name Locke-Theis "B" No. 1

TOPS	DEPTH	LOG	DATUM
Anh.			
Tp.			
H.		4324	
Tr.			
Dg.			
B.L.			
L.		4490	
K.C. <u>MD 25H</u>		5174	
B.K.C. <u>MD 25H</u>	5674	5674	
Ce. <u>CL</u>	5701	5701	
C.		5399	
M.		5709	
M.			
K.			
Mz.			
Mq.			
V.			
S.			
S.			
A.			
R.			
Pf.			
G.			
T.D.	5984		

Loc. in Sec. C SE NW

Geol. _____
 Contr. G-M #4

Pool McKinney

FEB 26 '58
0
ABANDONED

Date Comm. 1/30/58 (Shell - FO)

13" @ 100 w/250, 8" @ 600 w/235, Drlg. 2328

FEB 12 '58 Ø 4430 FEB 19 '58 Ø 5700

FEB 26 '58 end 5751 - 5811 na 60'

Li 25H NS DST 5760 - 5984

60" na 100' M BHP 140 - 100/45'

109

D 6 A