

STATE CORPORATION COMMISSION OF KANSAS
OIL & GAS CONSERVATION DIVISION

WELL COMPLETION OR RECOMPLETION FORM
ACO-1 WELL HISTORY

DESCRIPTION OF WELL AND LEASE

Operator: License # 4145
Name Roberts and Murphy, Inc
Address P. O. Box 7125
City/State/Zip Shreveport, LA 71137-7125

Purchaser NA

Operator Contact Person Brad Cummings
Phone 318-221-8601

Contractor: License # 6059
Name R & G Drilling

Wellsite Geologist Lee Jenkins
Phone 318-221-8601

Designate Type of Completion

- New Well Re-Entry Workover
- Oil SWD Temp Abd
- Gas Inj Delayed Comp.
- Dry Other (Core, Water Supply etc.)

If OWWO: old well info as follows:

Operator
Well Name
Comp. Date Old Total Depth

WELL HISTORY

Drilling Method:

- Mud Rotary Air Rotary Cable

7/1/85 7/22/85 8/4/85
Spud Date Date Reached TD Completion Date

6850 4400
Total Depth PBT

Amount of Surface Pipe Set and Cemented at 850 feet
Multiple Stage Cementing Collar Used? Yes No
if yes, show depth set feet
if alternate 2 completion, cement circulated from feet depth to w/SX cmt

API NO. 15-033-20,679

County Comanche

SW NW Sec 13 Twp 35 Rge 20 East West

2970 Ft North from Southeast Corner of Section
4950 Ft West from Southeast Corner of Section
(Note: Locate well in section plat below)


Lease Name Box Ranch Well # 1-13

Field Name Box Ranch

Producing Formation Toronto

Elevation: Ground 1688' KB 1700'

Section Plat

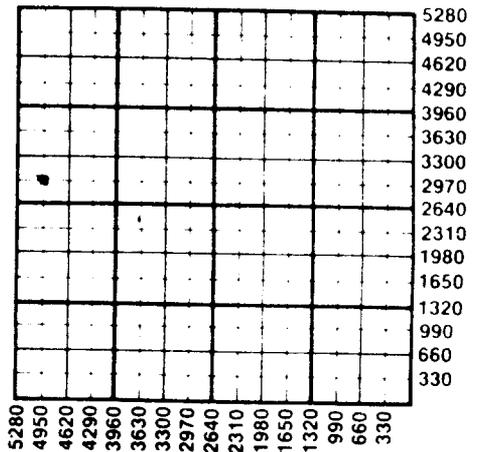

WATER SUPPLY INFORMATION

Disposition of Produced Water: Disposal Repressuring
Docket #

Questions on this portion of the ACO-1 call:

Water Resources Board (913) 296-3717

Source of Water:
Division of Water Resources Permit #

Groundwater Ft North from Southeast Corner (Well) Ft West from Southeast Corner of Sec Twp Rge East West

Surface Water Ft North from Southeast Corner (Stream, pond etc) Ft West from Southeast Corner Sec Twp Rge East West

Other (explain) (purchased from city, R.W.D. #)

INSTRUCTIONS: This form shall be completed in duplicate and filed with the Kansas Corporation Commission, 200 Colorado Derby Building, Wichita, Kansas 67202, within 90 days after completion or recompletion of any well. Rule 82-3-130 and 82-3-107 apply. Information on side two of this form will be held confidential for a period of 12 months if requested in writing and submitted with the form. See rule 82-3-107 for confidentiality in excess of 12 months. One copy of all wireline logs and drillers time log shall be attached with this form. Submit CP-4 form with all plugged wells. Submit CP-111 form with all temporarily abandoned wells.