

3-35-26W

STATE CORPORATION COMMISSION OF KANSAS OIL & GAS CONSERVATION DIVISION

WELL COMPLETION OR RECOMPLETION FORM ACO-1 WELL HISTORY

DESCRIPTION OF WELL AND LEASE

Operator: license # 8060 name Zinke & Trumbo, Ltd. address 111 W. 5th, Suite 220 City/State/Zip Tulsa, Okla. 74103

Operator Contact Person Ron F. Crowell Phone 918-592-5096

Contractor: license # 6333 name DaMac Drilling, Inc.

Wellsite Geologist Jim Milne Phone 918-592-5096

Designate Type of Completion

[X] New Well [ ] Re-Entry [ ] Workover

- [ ] Oil [ ] SWD [ ] Temp Abd [X] Gas [ ] Inj [ ] Delayed Comp. [ ] Dry [ ] Other (Core, Water Supply etc.)

If C/O: old well info as follows:

Operator Well Name Comp. Date Old Total Depth

WELL HISTORY

Drilling Method: [X] Mud Rotary [ ] Air Rotary [ ] Cable 10/15/85 10/27/85 10/29/85 Spud Date Date Reached TD Completion Date 6300' N/A Total Depth PBDT

Amount of Surface Pipe Set and Cemented at 1520 feet

Multiple Stage Cementing Collar Used? [ ] Yes [X] No

If Yes, Show Depth Set feet

If alternate 2 completion, cement circulated from feet depth to w/ SX cmt

API NO. 15 119-20,721 County Meade SE NW NW Sec 3 Twp 35S Rge 26 4290 Ft North from Southeast Corner of Section 4290 Ft West from Southeast Corner of Section (Note: locate well in section plat below)


Lease Name Wyatt Ranch Well# 1-3

Field Name McKinney

Producing Formation dry hole

Elevation: Ground 2308' KB 2317'

Section Plat

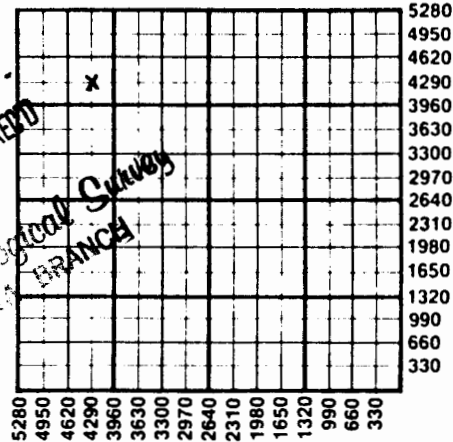

WATER SUPPLY INFORMATION

Source of Water: Division of Water Resources Permit #

[ ] Groundwater Ft North From Southeast Corner and (Well) Ft. West From Southeast Corner of Sec Twp Rge [ ] East [ ] West

[ ] Surface Water Ft North From Southeast Corner and (Stream, Pond etc.) Ft West From Southeast Corner Sec Twp Rge [ ] East [ ] West

[ ] Other (explain) (purchased from city, R.W.D.#)

Disposition of Produced Water: [ ] Disposal [ ] Repressuring

Docket #

INSTRUCTIONS: This form shall be completed in duplicate and filed with the Kansas Corporation Commission, 200 Colorado Derby Building, Wichita, Kansas 67202, within 90 days after completion or recompletion of any well. Rules 82-3-130 and 82-3-107 apply.

Information on side two of this form will be held confidential for a period of 12 months if requested in writing and submitted with the form. See rule 82-3-107 for confidentiality in excess of 12 months.

One copy of all wireline logs and drillers time log shall be attached with this form. Submit CP-4 form with all plugged wells. Submit CP-111 form with all temporarily abandoned wells.