

9-35-26 W

STATE CORPORATION COMMISSION OF KANSAS  
OIL & GAS CONSERVATION DIVISION

WELL COMPLETION OR RECOMPLETION FORM  
ACO-1 WELL HISTORY

DESCRIPTION OF WELL AND LEASE

Operator license # 8060  
name Zinke & Trumbo, Ltd.  
address 111 W. 5th., Suite 220  
City/State/Zip Tulsa, Okla., 74103

Operator Contact Person Ron F. Crowell  
Phone 918-592-5096

Contractor license # 6333  
name DaMac Drilling, Inc.

Wellsite Geologist Jim Milne  
Phone 918-592-5096

Designate Type of Completion

- New Well  Re-Entry  Workover
- Oil  SWD  Temp Abd
- Gas  Inj  Delayed Comp.
- Dry  Other (Core, Water Supply etc.)

If OWWO: old well info as follows:

Operator  
Well Name  
Comp. Date Old Total Depth

WELL HISTORY

Drilling Method:  Mud Rotary  Air Rotary  Cable  
11/5/85 11/19/85 12/18/85  
Spud Date Date Reached TD Completion Date  
6400' 6353'  
Total Depth PBD

Amount of Surface Pipe Set and Cemented at 298 feet  
Multiple Stage Cementing Collar Used?  Yes  No

If Yes, Show Depth Set feet

If alternate 2 completion, cement circulated  
from 298 feet depth to surface w/ 260 SX cmt

API NO. 15 - 119-20735

County Meade

S/2 SE SW Sec 9 Twp 35 Rge 26

490 Ft North from Southeast Corner of Section  
3300 Ft West from Southeast Corner of Section  
(Note: locate well in section plat below)


Lease Name Cheney Well# 1-9C

Field Name McKinney

Producing Formation Chester

Elevation: Ground 2130' KB 2139'

Section Plat

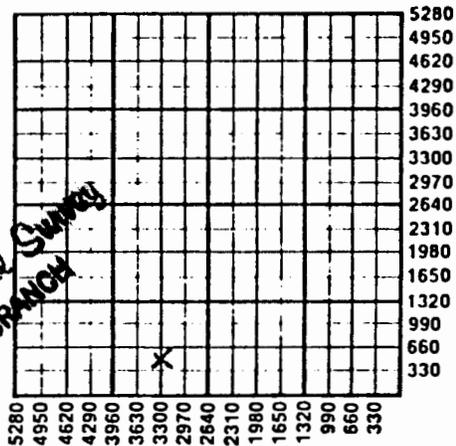

JAN 14 1986  
State Geological Survey  
WICHITA BRANCH

WATER SUPPLY INFORMATION

Source of Water:  
Division of Water Resources Permit #

Groundwater Ft North From Southeast Corner and  
(Well) Ft. West From Southeast Corner of  
Sec Twp Rge  East  West

Surface Water Ft North From Southeast Corner and  
(Stream, Pond etc.) Ft West From Southeast Corner  
Sec Twp Rge  East  West

Other (explain)  
(purchased from city, R.W.D.#)

Disposition of Produced Water:  Disposal  Repressuring

Docket #

INSTRUCTIONS: This form shall be completed in duplicate and filed with the Kansas Corporation Commission, 200 Colorado Derby Building, Wichita, Kansas 67202, within 90 days after completion or recompletion of any well. Rules 82-3-130 and 82-3-107 apply.  
Information on side two of this form will be held confidential for a period of 12 months if requested in writing and submitted with the form. See rule 82-3-107 for confidentiality in excess of 12 months.  
One copy of all wireline logs and drillers time log shall be attached with this form. Submit CP-4 form with all plugged wells. Submit CP-111 form with all temporarily abandoned wells.