SIDE ONE 1-35-27W

STATE CORPORATION COMMISSION OF KANSAS
OIL & GAS CONSERVATION DIVISION
WELL COMPLETION OR RECOMPLETION FORM
ACO-1 WELL HISTORY
DESCRIPTION OF WELL AND LEASE

Operator: License # 08060
Name Zinke & Trumbo, Ltd.
Address 1202 E. 33rd St., Suite 100
Tulsa, OK 74105
City/State/Zip

Purchaser Enron
Texaco

Operator Contact Person Dave Trumbo
Phone 918-743-5096

Contractor: License # 5421
Name Sage Drilling

Wellsite Geologist Jim Milne
Phone 305-681-4286

Designate Type of Completion
X New Well ___ Re-Entry ___ Workover

___ Oil ___ SWD ___ Temp Abd
X Gas ___ Inj ___ Delayed Comp.
___ Dry ___ Other (Core, Water Supply etc.)

If OWWO: old well info as follows:
Operator
Well Name
Comp. Date Old Total Depth

WELL HISTORY

Drilling Method:
X Mud Rotary ___ Air Rotary ___ Cable

1-30-89	2-10-89	3-8-89
Spud Date	Date Reached TD	Completion Date

6517	6427
Total Depth	PBTD

Amount of Surface Pipe Set and Cemented at 576 feet
Multiple Stage Cementing Collar Used? ___ Yes X No
if yes, show depth set feet
If alternate 2 completion, cement circulated
from feet depth to w/ SX cmt
Cement Company Name
Invoice #

API NO. 15- 119-20,784

County Meade

C NE NE Sec. 1 Twp. 35 Rge. 27 ___ East X West

4620 Ft North from Southeast Corner of Section
660 Ft West from Southeast Corner of Section
(Note: Locate well in section plat below)

Lease Name Bernnie Well # 1

Field Name McKinney

Producing Formation Ste. Gen

Elevation: Ground 2166 KB 2178

Section Plat

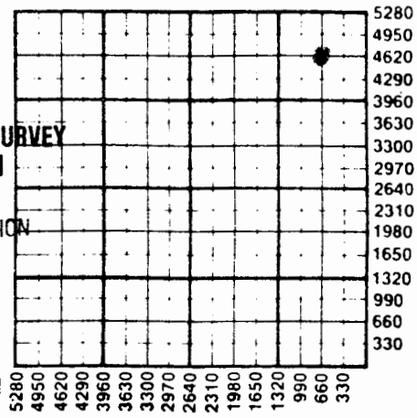

APR 2 1 1989
KANSAS GEOLOGICAL SURVEY
WICHITA BRANCH
RECEIVED
STATE CORPORATION COMMISSION
APR 17 1989
CONSERVATION DIVISION
Wichita, Kansas

WATER SUPPLY INFORMATION

Disposition of Produced Water: ___ Disposal
Docket # ___ Repressuring

Questions on this portion of the ACO-1 call:
Water Resources Board (913) 296-3717

Source of Water:
Division of Water Resources Permit # T89-058

X Groundwater 4560 Ft North from Southeast Corner
(Well) 660 Ft West from Southeast Corner of
Sec Twp Rge ___ East ___ West

___ Surface Water Ft North from Southeast Corner
(Stream, pond etc) Ft West from Southeast Corner
Sec Twp Rge ___ East ___ West

___ Other (explain)
(purchased from city, R.W.D. #)

INSTRUCTIONS: This form shall be completed in triplicate and filed with the Kansas Corporation Commission, 200 Colorado Derby Building, Wichita, Kansas 67202, within 120 days of the spud date of any well. Rule 82-3-130, 82-3-107 and 82-3-106 apply.
Information on side two of this form will be held confidential for a period of 12 months if requested in writing and submitted with the form. See rule 82-3-107 for confidentiality in excess of 12 months.
One copy of all wireline logs and drillers time log shall be attached with this form. Submit CP-4 form with all plugged wells. Submit CP-111 form with all temporarily abandoned wells.

All requirements of the statutes, rules and regulations promulgated to regulate the oil and gas industry have been fully complied with and the statements herein are complete and correct to the best of my knowledge.

Signature
Title Agent Date 4-11-89

Subscribed and sworn to before me this 11th day of April 19 89
Notary Public Bevelyn J. Jones
Date Commission Expires February 2, 1993

BEVELYN J. JONES
Notary Public - State of Kansas
My Appt. Expires 2/2/93

K.C.C. OFFICE USE ONLY
(F) ✓ Letter of Confidentiality Attached
(C) ✓ Wireline Log Received
C ___ Drillers Timelog Received
Distribution
✓ KCC ___ SWD/Rep ___ NGPA
✓ KGS ___ Plug ___ Other (Specify)

Sec. 1 Twp. 35 Rge. 27W

Form ACO-1 (5-86)