

STATE CORPORATION COMMISSION OF KANSAS
OIL & GAS CONSERVATION DIVISION

WELL COMPLETION OR RECOMPLETION FORM
ACO-1 WELL HISTORY

DESCRIPTION OF WELL AND LEASE

Operator: License # 5020
Name Rine Exploration Company
Address Suite #645
300 W. Douglas
City/State/Zip Wichita, KS 67202

Purchaser Total Petroleum, Inc.
Oklahoma City, OK 73116

Operator Contact Person M. Bradford Rine
Phone 316/262-5418

Contractor: License # 5381
Name Big Springs Drilling, Inc.

Wellsite Geologist M. Bradford Rine
Phone 316/262-5418

Designate Type of Completion

☒ New Well ☐ Re-Entry ☐ Workover

☒ Oil ☐ SWD ☐ Temp Abd
☐ Gas ☐ Inj ☐ Delayed Comp.
☐ Dry ☐ Other (Core, Water Supply etc.)

If OWWO: old well info as follows:

Operator
Well Name
Comp. Date Old Total Depth

WELL HISTORY

Drilling Method:

☒ Mud Rotary ☐ Air Rotary ☐ Cable

09/07/85 09/20/85 10/15/85
Spud Date Date Reached TD Completion Date
4974' 4973'
Total Depth PBTD

Amount of Surface Pipe Set and Cemented at 628 feet
Multiple Stage Cementing Collar Used? ☐ Yes ☒ No
if yes, show depth set feet
If alternate 2 completion, cement circulated
from feet depth to w/ SX cmt

API NO. 15-191-21,867

County Summer

NE 1/4 SW 1/4 NE 1/4 Sec. 7 Twp. 35S Rge. 3W ☒ East ☒ West

3630 Ft North from Southeast Corner of Section
1650 Ft West from Southeast Corner of Section

(Note: Locate well in section plat below)


Lease Name Jenista Well # 1-7

Field Name Wildcat

Producing Formation Simpson

Elevation: Ground 1155' KB 1160'

Section Plat

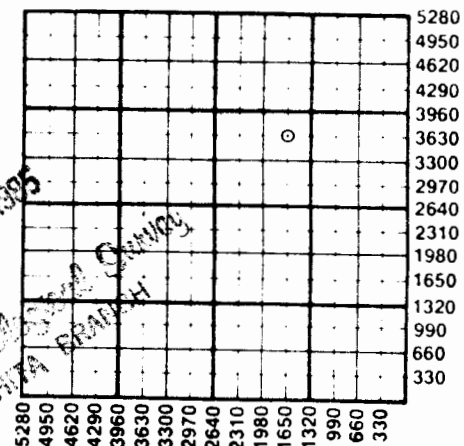

WATER SUPPLY INFORMATION

Disposition of Produced Water: ☐ Disposal
Docket # ☐ Repressuring

Questions on this portion of the ACO-1 call:

Water Resources Board (913) 296-3717

Source of Water:

Division of Water Resources Permit #

☐ Groundwater Ft North from Southeast Corner
(Well) Ft West from Southeast Corner of
Sec Twp Rge ☐ East ☐ West

☒ Surface Water Ft North from Southeast Corner
(Stream, pond etc) Ft West from Southeast Corner
Sec Twp Rge ☐ East ☐ West

Bought from Landowner

☐ Other (explain)
(purchased from city, R.W.D. #)

INSTRUCTIONS: This form shall be completed in duplicate and filed with the Kansas Corporation Commission, 200 Colorado Derby Building, Wichita, Kansas 67202, within 90 days after completion or recompletion of any well. Rule 82-3-130 and 82-3-107 apply.

Information on side two of this form will be held confidential for a period of 12 months if requested in writing and submitted with the form. See rule 82-3-107 for confidentiality in excess of 12 months.

A copy of all wireline logs and drillers time log shall be attached with this form. Submit CP-4 form with logged wells. Submit CP-111 form with all temporarily abandoned wells.