

Morton

KANSAS

SECTION 3 TOWNSHIP 35 RANGE 42W

WELL NO. #2 Fowler


COMPANY Panhandle

NORTH

C SW

WEST

EAST

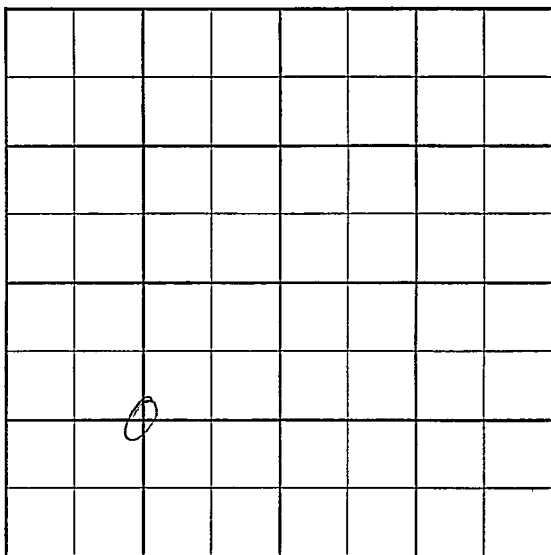

SOUTH

34

S-513-A

CO. Morton ELEV. _____
SEC. 3 TWP. 35 RGE. 42W
COMPANY Panhandle NO. 2

FIRST REPORT
SEP 25 57

FARM Fowler
LOC. C SW 1340' SL
1255' EL

GEOL. _____
CONTR. H & H Drlg.
POOL Greenwood
SPUD 9-11-57
7" @ 632/300 drlg. 2458

NO. SEC. TWP. RGE.

S-513-A

CO. Morton ELEV. 35600
 SEC. 3 TWP. 35 RGE. 12W
 COMPANY Panhandle NO. 2-3

JAN 15 '58

CO.

COMPLETE

FARM Fowler

LOC. C SW 1340' SL 1255' EL

GEOL.

CONTR. H & H Drilg.POOL GreenwoodSPUD 9-11-57

7" @ 632/300 drilg. 2458

DST 3119-65

1 hr C/23" TSTM

rec 180' GCM FP

O BHP 380/20

run log 4 1/2" 3215/100

JIT 9 32

RTD 3215

log Wab 2684 TP 2577

2684 304 CD 36/ 3147-56

8/ 3121-23 A 7B SWPH

PB 3070 104/2996-3022

24/2976-82 20/2941-46

20/2924-29 A ga 9.900 mcf

MIST SW A run tbg

DEC 4 '57

NOV 20 '57

JAN 2 '58

JAN 8 '58

JAN 5 '58

State

2.452 mcf RP 457

BTU 945

Topeka 2924-3022

PBTID 2070

LSE.

Z.O.

SEC.

TWP.

RGE.