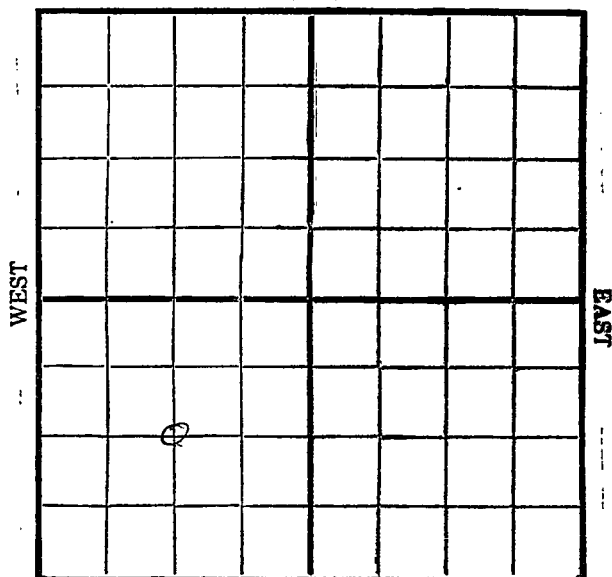


Stevens
 Map No. KANSAS Sec. 3 Twp. 35 R. 38^W
 Well No. 1-Grandey Farm
Benedum & Sons Company

NORTH



SOUTH

Location _____

Drilling Remarks _____

Rig Up _____

Drilling Remarks _____

RECORD

Cased _____ in. _____ ft.

Sand _____

Gas _____

Oil _____

Total Depth _____

PRODUCTION

1st 24 hrs. Nat. _____

1st 24 hrs. after shot _____

Gas _____ cu. ft.

Dry Hole _____

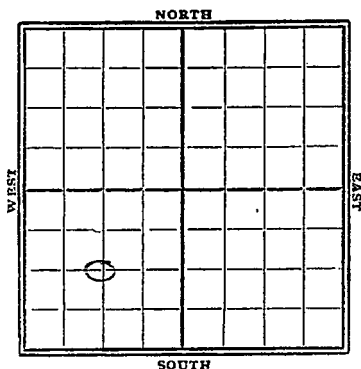
Abandoned _____

Map No. KANSAS Sec. 3 Twp. 35 R. 38WWell No. 1-Grandy Farm
Benedum Trees Company

_____ Ft. from N. Line

1320 Ft. from S. Line

_____ Ft. from E. Line

1320 Ft. from W. Line1929

Date	REPORT
8/21	Bldg lig
8/28	Rign up
9/4	Spud
9/11	No report
9/18	—
9/25	Spud
10/2	Orly 1335'
10/9	" 1600'
10/16	" 1900
10/23	" 2175'
10/30	SD 2230'
11/6	—
11/13	—
11/20	—
11/27	2230-Rust
12/4	no report
12/11	all of 2320
12/18	Top line 2615'
	show gas
	Orly 2665'
	(over)

12/23- sand 2615-2780'

T.D. 2780'

11 Agas

Sony

Map No. KANSAS Sec. 3 Twp. 35 R. 38WWell No. 1 GrandyBenedum Bros. Company

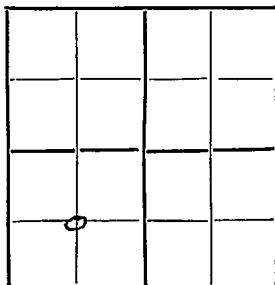
Contractor

SECTION PLAT

Ft. from N. Line

1320 Ft. from S. Line

Ft. from E. Line

1320 Ft. from W. Line

FIRST REPORTS

Location

Rig up

Drilling and Remarks:

Rotary
Building rig
S. J.

RECORD

Cased in., ft.

Sand

Gas

Oil

Total Depth

PRODUCTION

1st 24 hrs. Nat.

1st 24 hrs. after shot

Gas Cu. Ft.

Dry Hole

Abandoned

Date

AUG 21 1924

192

S. J. LEWIS

Scout

no trace
no way

Returned	
Cards	
Tracing	22 max
France Map	
Scarborough Map	
Mood, &	
Scarborough	
Albany	

Map No. KANSAS Sec. 8 Twp. 35 R. 38WWell No. 1 GranadyBenedum Bros. Company

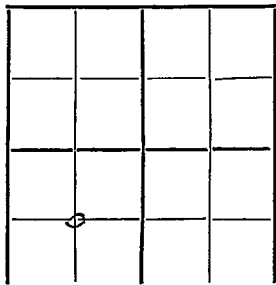
Contractor

SECTION PLAT

Ft. from N. Line

1820 Ft. from S. Line

Ft. from E. Line

1820 Ft. from W. Line

COMPLETED

Location

Rig up

Drilling and Remarks:

11 M Gas.

RECORD

Cased _____ in., _____ ft.

Sand 2615 - 2780

Gas _____

Oil _____

Total Depth 2780

PRODUCTION

1st 24 hrs. Nat. _____

1st 24 hrs. after shot _____

Gas _____ Cu. Ft.

Dry Hole _____

Abandoned _____

Date

DEC 23 1929S. J. LEWIS Scout

*no success
upwards*

Returned	<i>CP</i>
Cards	
Tracing	<i>Transp</i>
France Map	
Scarborough	<i>X</i>
Moody's	
Scoring	
Map	