

Form 51-5M-4-27-27423
KANSAS
Map No. _____ Sec. 3 Twp. 35 R. 38 W.
Well No. 1 Grandy Farm
Tree oil Company

NORTH

WEST

EAST

SOUTH

Location_____

Drilling Remarks

Rig Up

Drilling Remarks

RECORD

Cased_____in. _____ft.

Sand _____

Gas

Oil

Total Depth_____

PRODUCTION

1st 24 hrs. Nat. _____

1st 24 hrs. after shot_____

Gas _____ cu. ft.

Dry Hole_____

Abandoned


Map No. **KANSAS** Sec. **3** Twp. **35** R. **38** W
 Well No. **1** - **Grandy** Farm
Tree Oil Company

990 Ft. from N. Line

_____ Ft. from S. Line

990 Ft. from E. Line

_____ Ft. from W. Line

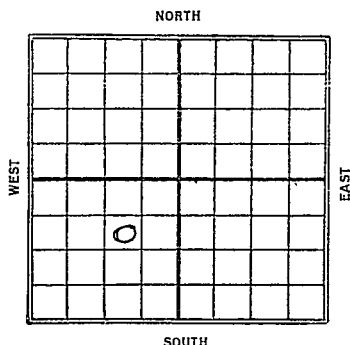

1928

Date	REPORT
6/27	R.O.G.
7/3	no report.
7/11	Drill water well
7/18	Spud 210
7/25	T.D. 280- fog bailer -
8/1	Drill 520
8/7	" 535
8/15	No report
8/22	T.D. 600 pipe trouble
9/5	T.D. 600 pipe trouble
9/12	No report
9/19	Fighting quick sand
9/26	
10/3	
10/10	
10/17	
10/24	No report
10/31	
11/7	Last hole at 606'
	skidding rig
11/14	
11/21	

11/28 Lost hole at 606'
 Skidding Rig
 12/5 - no report
 12/12 _____
 12/19 _____
 12/26 _____
 1929 _____
 1/2 _____
 1/9 Shut down
 1/16 _____
 1/23 drlg 350'
 1/30 " 370'
 2/6 " 430'
 2/13 fsq pipe 430' T.D.
 2/20 _____
 2/27 - Ply out 430' - T.D.
 3/13 - drlg 500'
 3/20 set 12" - 505'
 3/27 No report
 4/3 _____
 4/10 _____
 4/17 _____
 4/24 - S.D. 700' - T.D.
 To move in Rotary
 5/1 _____
 5/8 _____
 5/15 T.D. 700'
 Dry & Abandoned

Map No. KANSAS Sec. 3 Twp. 35 R. 38W

Well No. 1

Trces Oil Company

Contractor

SECTION PLAT

990 Ft. from N. Line

_____ Ft. from S. Line

990 Ft. from E. Line

_____ Ft. from W. Line

	0		

FIRST REPORTS

Location _____

Rig up _____

Drilling and Remarks:

ROG

RECORD

Cased _____ in., _____ ft.

Sand _____

Gas _____

Oil _____

Total Depth _____

PRODUCTION

1st 24 hrs. Nat. _____

1st 24 hrs. after shot _____

Gas _____ Cu. Ft.

Dry Hole _____

Abandoned _____

Date

JUN 27 1928

192

S. J. LEWIS

Scout

no small map
will
two

Returned	
Cards	
Tracing	<i>no map</i>
France Map	<i>no map</i>
Scarborough Map	<i>X</i>
Moody Map	
Scarborough Plat Book	
Moody Plat Book	

Map No. KANSAS Sec. 3 Twp. 35 R. 38WWell No. 1 GrandyTrees Oil Company

Contractor

SECTION PLAT

990 Ft. from N. Line

Ft. from S. Line

990 Ft. from E. Line

Ft. from W. Line

	0		

ABANDONED

Location

Rig up

Drilling and Remarks:

DSH

RECORD

Cased in., ft.

Sand

Gas

Oil

Total Depth 700

PRODUCTION

1st 24 hrs. Nat.

1st 24 hrs. after shot

Gas Cu. Ft.

Dry Hole

Abandoned

Date

MAY 15 1929

192

S. J. LEWIS

Scout

no answer
no work

Returned	
Cards	<i>THB</i>
Tracing	<i>THB</i>
France Map	<i>THB</i>
Scarborough Map	<i>THB</i>
Moody Map	<i>THB</i>
Scarborough Plat Book	<i>THB</i>
Moody Plat Book	<i>THB</i>