

Map No. ANSAS Sec. 3 Twp. 35 R. 34^S_WWell No. Boles Farm
Trader Oil Company

NORTH

WEST

		⊙					

EAST

SOUTH

Location.....

Drilling Remarks

Rig Up.....

Drilling Remarks

RECORD

Cased..... in..... ft.

Sand.....

Gas.....

Oil.....

Total Depth.....

PRODUCTION

1st 24 hrs. Nat.....

1st 24 hrs. after shot.....

Gas..... cu. ft.

Dry Hole.....

Abandoned.....

Map No. Sec. Twp. R.

Well No. Farm


..... Company

..... Ft. from N. Line

..... Ft. from S. Line

..... Ft. from E. Line

..... Ft. from W. Line

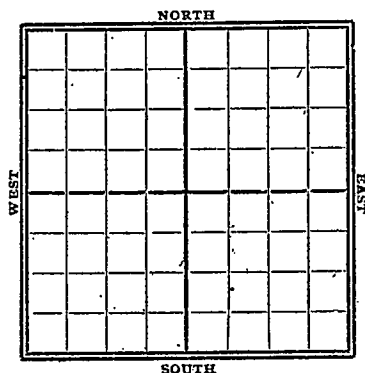

Date

REPORT

Gypsy Records

6/3

Abd TD 2919'

MAP No. _____ SEC. 3 TWP. 35 S. 3 W.WELL No. 1 BakerTraders Oil COMPANYno wall mup CONTRACTOR

SECTION PLAT

_____ FT. FROM N. LINE

_____ FT. FROM S. LINE

_____ FT. FROM E. LINE

_____ FT. FROM W. LINE

RECORD

LOCATION _____

CASED _____ IN. _____ FT.

RIG UP _____

SAND _____

DRILLING AND REMARKS:

GAS /

OIL _____

TOTAL DEPTH 2919

PRODUCTION

1ST 24 HRS. NAT. _____

1ST 24 HRS. AFTER SHOT _____

GAS 500 CU. FT.

DRY HOLE _____

ABANDONED _____

DATE

June 3 192 7 SCOUT