


Meade

KANSAS
30W

SECTION 3 TOWNSHIP 35 RANGE 30W

WELL NO. #1 Fox

COMPANY Republic Nat. Gas

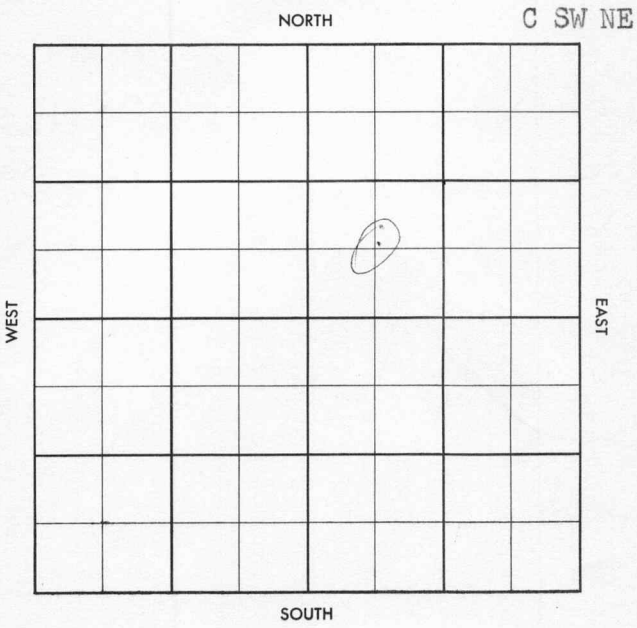

County Meade Elev. _____
Sec. 3 Twp. 35 Rge. 30W
Company Republic Nat. Gas
FarmName Fox No. 1

TOPS	DEPTH	LOG	DATUM
Anh.			
TP.			
H.			
Tr.			
Dg.			
Bl.			
L.			
K.C.			
B.K.C.			
Ce.			
C.			
M.			
M.			
K.			
Mz.			
Me.			
V.			
S.			
S.			
A.			
R.			
Pe.			
G.			
T.D.			

Loc. in Sec. C SW NE
510' fsl x
660' fwl NE
Geol. _____
Contr. _____
Moran Tools
Pool _____
Adams Ranch

FIRST REPORT	
O	
JUN 5 '57	

Date Comm. 5-31-57
10" @ 609/600, Drlg. 1590

35

K-23

FORM 513 SUNRAY

County Meade Elev. 2557
 Sec. 3 Twp. 35 Rge. 30W
 Company Republic Nat. Gas
 Farm Name Fox No. 1

TOPS	DEPTH	LOG	DATUM	Loc. in Sec.
Anb. <u>Herr</u>		<u>2580</u>		<u>C SW NE</u>
Tp. <u>cn 9n</u>	<u>3018</u>	<u>3024</u>		
H.				<u>510' fsl x</u>
Tr.	<u>4406</u>	<u>4396</u>		
Dg.				<u>660' fwl NE</u>
BL.				
L.	<u>4518</u>	<u>4526</u>	<u>-1969</u>	<u>Geol.</u>
K.C. <u>Hudges</u>	<u>5020</u>			
B.K.C.				<u>Contr.</u>
Ce. <u>chk b d</u>	<u>5082</u>			
C.				<u>Moran Tools</u>
M. <u>Marm</u>	<u>5203</u>	<u>5203</u>	<u>2495</u>	
M. <u>MW</u>	<u>5288</u>	<u>5268</u>	<u>-3211</u>	<u>Pool</u>
K. <u>" sd</u>	<u>5802</u>	<u>5793</u>		
Mz. <u>" "</u>		<u>5847</u>		<u>Adams Ranch</u>
Me. <u>ce</u>		<u>5389</u>		
V. <u>Miss</u>		<u>5910</u>	<u>-3253</u>	<u>COMPLETE</u>
S. <u>st 6 in</u>		<u>6126</u>	<u>-3569</u>	
S.				<u>JAN 5 '57</u>
A.				
R.				<u>o</u>
PE.				
G.				<u>COMPLETE</u>
T.D.	<u>6237</u>			

Date Comm. 5-31-57

10" @ 609/600, Drlg. 1590 JUN 12 '57

7" @ 2594/100 D 2930

JUN 19 '57 X DST 3090-3117 op 1 hr

6 1/2" ga. 2.862 MCFG/58" rec.

70' SW FP 600-690 BHP 885

120" DST 4410-25 op 32"

ga. 1 1/2" oily Md in 5 1/2" ga.

5.157 MCFG/120" rec. 180' oil

gravel 45' + 10' SW BHP 1568/120"

FP 1430-1390 D 4563 JUN 26 '57

DST 5077-91 1hr 560' SGC
 SW FP 90-355 1725/20"
 DST 5204-24 1hr G/6"
 STAB. 1 @ 66 MCF/L net 900' oil
 + 600' SW FP 105-295 BHP
 700/20" DST 5363-73 1hr
 20' S.E. GCM FP 35-35
 BHP 390/20 MD 5498 JUL 3 '57
 DST 5802-11 1hr G/2" STAB
 @ 947 MCF/30" net 5800' Gipe
 + 550 FP 120-140 BHP 2000/
 DST 5850-65 1hr 20' Md
 BHP 1675/30" DST 5893-59
 1hr G/2" ga 2,072 MCF/5"
 ga 2,468 MCF/30" BHP
 1975/30" MD 6020 JUL 10 '57 4 1/2
 5981/490 MICT JUL 17 '57 CO 5916
 28/5889-96 16/5793-97
 ga 2,123 MCF/L 2 1/2 hrs Fraz
 1/2 ga 13,714 MCF/L in 1 1/2 hrs
 JUL 24 '57 BRDg P/9 @ 5753 24/4402
 -08 ga 3,287 MCF/L 1/2
 Flwg Oil-SW-E' GAS JUL 31 '57 Flowed
 30 BO + 27 BSW @ ga 500 MCF/L
 1/4" ch FTP 840 FCP 1115 # ~~SEP~~
 TP 1200 CP 1210 # AUG 6 '57 AUG 14 '57 (W.O.)
 connections (~~XXXXXX~~ ~~XXXXXX~~ ~~XXXXXX~~ ~~XXXXXX~~)
 AUG 21 '57 to the CSR AUG 28 '57 SEP 4 '57 SEP 11 '57
 SEP 18 '57 SEP 25 '57 OCT 2 '57 OCT 9 '57 OCT 16
 OCT 23 '57 OCT 30 '57 NOV 6 '57 NOV 13 '57 NOV 20 '57 NOV 27 '57
 3-35-30W @ SW NE

DEC 4 '57

Hooked to D10

DEC 11 '57

DEC 18 '57

DEC 26 '57

JAN 2 '58

JAN 8 '58

C. D. M. P. A. Y.
JAN 15 '58

B/O DOWN

+ hru tbg PKV 5753

13.714 met SICP 1643

narrow

T10 N to F10 3050

27BW 24hrs $\frac{1}{4}$ " LK

FP 840 FCP 1115

ga 500 met

DUD1

new pay discovery
akams Banet

3-35-30W

CSW NE