


Section 3 Township 35 Range 10WWell No. 1 L. T. HewleyCompany Sinclair O&G

NORTH

WEST

EAST

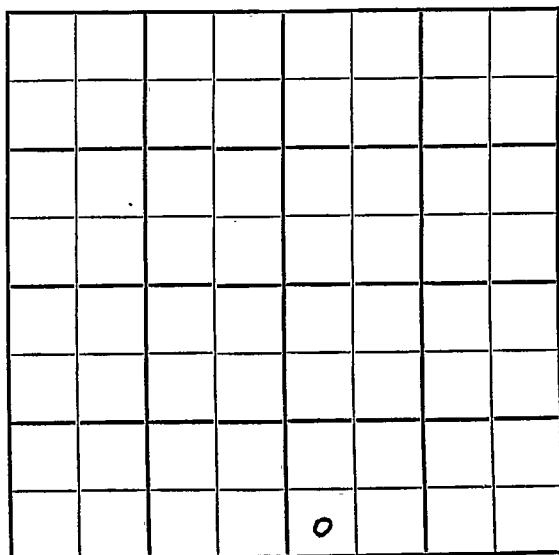

SOUTH

SEC.	TWP.	R.
3	35	10W

WELL NO.

#1 L.T. Henley

FARM

COMPANY

Sinclair Oil & Gas

CONTRACTOR

Adkins

Gudeman Pool

NORTH

Ft. from N. Line

330

Ft. from S. Line


Ft. from E. Line

330

Ft. from W. Line

WEST

EAST

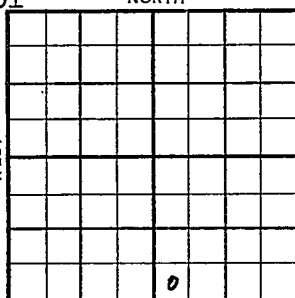

SOUTH

SW SW SE

	ELEVATION	REPORT
1955	1286'	

1/19

MIR

Arb Test

3/9

Spud 1-18-55 D & A TD 5488
 10" @ 231 Heeb 3611 Tor. 3618
 Stal. 3942 KC 4200 Miss 4710
 DST 4727-67 open 1 hr rec 120' gassy
 mud oil spk. 0#
 DST 4766-4806, open 1 hr rec 105'
 mud, 1615# Maq. 5083' Viola 5146'
 Simp. 5232'
 DST 5232-53 open 1 hr rec 15' mud
 30# Schl tops: Heeb 3618',
 Tor. 3630', Doug 3656', Stal. 3954',
 KC 4207', Cherokee 4647', Miss 4720'
 Maq. 5092', Viola 5149', Simp. 5236'
 Arb. 5460' TD 5488'
 D & A

ABANDONED

County Barber State Kansas

Sec. **3** (Blk. **35** (Sur. **10W** Map No.

Operator **Sinclair Oil & Gas**

Well No. **I** Farm **L. T. Hemley**

Elev.	Location	SW	SW	SE
-------	----------	----	----	----

FIRST REPORT

330 Ft. From S Line SE

330 Ft. From W Line Quarter

1st. Report JAN 19 1955

Completion

Remarks Arb. test

Adkins - Contr.


Spudding Date _____

Drig. Data

U T R

FABEN GILSTRAP

County Barber State Kansas
 Sec. 3 (Blk. 3 5 (Sur. 10W Map No.
 Operator Sinclair Oil & Gas
 Well No. 1 Farm L. T. Hemley
 Elev. 1286 Location SW SW SE

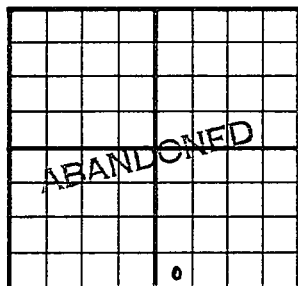

330 Ft. From S Line SE
330 Ft. From W Line Quarter
 1st. Report
 Completion MAR 9 1955
 Remarks Gudeman Pool
Adkins - Contr.
 Spudding Date 1-18-55

Drig. Data D & A TD 5488
10" @ 231 Heeb. 3611 Tor. 3618
Stal. 3942 KC 4200 Miss. 4710
DST 4727-67 open 1 hr. Rec. 120' gassy
mud oil spk. 0# DST 4766-4806 open 1 hr
Rec. 105' mud 1615# Maq. 5083
Viola 5146 Simp. 5232 DST 5232-53
open 1 hr. Rec. 15' mud 30#
SCHLUMBERGER TOPS:
Heeb. 3618 Tor. 3630 Doug. 3656
Stal. 3954 KC 4207 Cherokee 4647
Miss. 4720 Maq. 5092 Viola 5149
Simp. 5236 Arb. 5460 TD 5488

D & A

FABEN GILSTRAP