

Harper

KANSAS

SECTION 3 TOWNSHIP 35 RANGE 7 W

WELL NO. # 1 Burchfield

COMPANY C. H. Nicholson

NORTH

WEST

EAST

				0			

SOUTH

Harper

KANSAS

SEC.	TWP.	R.
3	35	7W

WELL NO.

#1 Burchfield

FARM

COMPANY

C.H. Nicholson

CONTRACTOR

Davis & Wharton

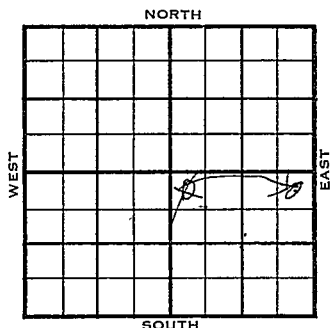
WILDCAT

_____ Ft. from N. Line

_____ Ft. from S. Line

_____ Ft. from E. Line

_____ Ft. from W. Line

NE NE
~~NW NW~~ SE

	ELEVATION	REPORT
1956	1333'	

4-25 RUR

5-29 Comm. 4-24-56
 10 3/4" @ 146 w/125
 DST 5381-92 op 1 hr. rec. 340' mud,
 All press 0#.
 D & A
 M. 4780', V. 5280', S. 5348',
 Log tops:Dg. 3593', Tonka 3851',
 KC. 4115', Cotl. Grove 4178',
 Skiat. 4290, Marm 4446', M. 4788',
 ## Wood. 5183', Wd Fd. 5266',
 V. 5286, A. 5554', S. 5350'.
 TD 5610'

ABANDONED

County Harper Elev. _____
 Sec. 3 Twp. 35 Rge. 7W
 Company G. H. Nicholson
 FarmName Burchfield No. 1

TOPS	DEPTH	LOG	DATUM	Loc. in Sec.
Anh.				NW NW SE
TP.				
H.				
Tr.				
Dg.				
BL.				
L.				Geol. _____
K.C.				Contr. _____
B.K.G.				Davis & Wharton
Ce.				
C.				Pool
M.				Wildcat
M.				
K.				
Mz.				
Mq.				
V.				
S.				
S.				FIRST REPORT
A.				
R.				
Pe.				
G.				
T.D.				APR 25 '56

Date Comm.

R U R

MAY 5 1956

R. G.

27

CORRECTION

FORM 513 SUNRAY

County Harper Elev. 1335
 Sec. 3 Twp. 35 Rge. 7W
 Company C. H. Nicholson
 FarmName Burchfield No. 1

TOPS	DEPTH	LOG	DATUM
Anh.			
Tr.			
H.			
Tr.			
Dg.		3593	
Bl. <u>Tonka</u>		3851	2518
L.			
K.C.		4115	2722
BK. <u>CoH grok</u>		4178	2515
Gr. <u>SKiat</u>		4290	2951
C. <u>Marm</u>		4446	3112
M.	4780	4788	3453
M.			
K. <u>wood</u>		5183	3850
M. <u>WdFd</u>		5266	3950
Mo.			
V.	5280	5286	2953
S.	5348	5350	4017
S.			
A.		5554	4221
R.			
PE.			
G.			
TD.	5610		

Loc. in Sec.

NW-NW-SE
NE-NE

Geol.

Contr.

Davis & Wharton

Pool

Wildcat

ABANDONED

Date Comm. Huber BH. Ac. Purch.

RUR MAY 2 '56 4-24-56 10 3/4 146

1125 ϕ 2723 MAY 9 '56 ϕ 4352 MAY 16 '56
 ϕ 5035 MAY 23 '56 ϕ 5375 (broke down)
 MAY 29 '56 DST 5381-92 1hr. rec.
 340' Md All press 0

DEA