


Section 3 Township 35 Range 3 W

Well No. # 1 Devorak

Company Metropolitan

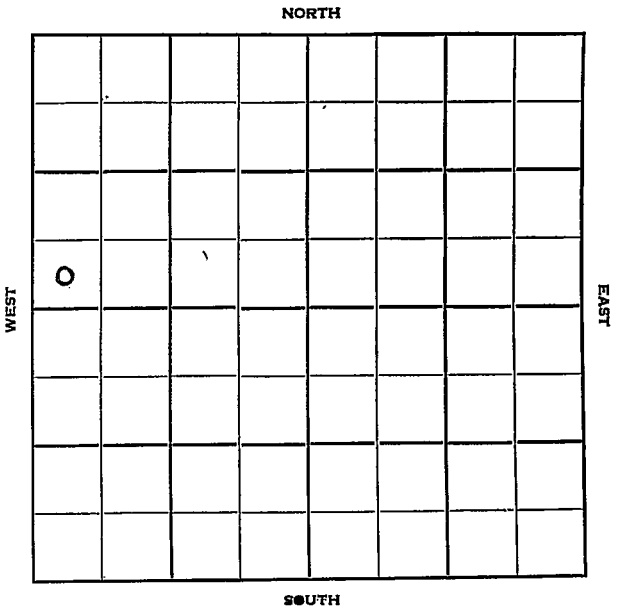

Sec. 3 Twp. 35 R. 3W

Well No. #1 Devroak Farm

Metropolitan Company


Texas Farmout Contractor

         Ft. from N. Line

390 Ft. from S. Line

         Ft. from E. Line

330 Ft. from W. Line

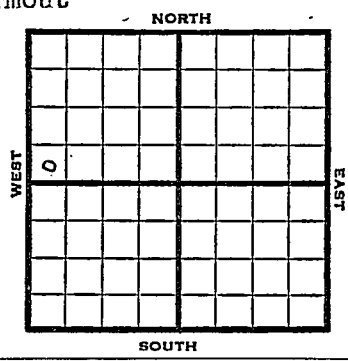

SW SW NW

MCPC has all of Sec. 8  
except N/2 of SE

1952

Elev. 1148' REPORT

2/20

Spud -  
8" @ 638'

Drlg. 2635

3/5

Stal 3162 Lay 3617  
Lans. 3664 Miss 4412  
Drg. 4542'

3/12

KH 4748 V 4818 Drlg. 4856'

3/19

D & A TD 4856' 8" @ 638'  
DST 3720-28 open 1 hr. rec 8' mud  
Stal. 3162' Layton 3617' Lans. 3664'  
Miss 4412' Kh. 4748' Viola 4818'  
Simp. 4833'  
DST 4826-56 open 1 hr. rec 65' GCM  
& 400' HGCM, 510' SW  
TD 4856' D & A

**ABANDONED**



County Sumner State Kansas  
 Sec. 3 (Blk. Twp.) 35 (Sur. Rge.) 3W Map No. \_\_\_\_\_  
 Operator Metropolitan  
 Well No. 1 Farm Devorak  
 Elev. 1148 Location SW SWNW


**ABANDONED**

330 Ft. From S Line NW  
330 Ft. From W Line Quarter  
 Ist. Report \_\_\_\_\_  
 Completion MAR 19 1952  
 Remarks \_\_\_\_\_  
 Spudding Date \_\_\_\_\_

Drlg. Data D & A TD 4856  
8" @ 638 DST 3720-28 open 1 hr.  
Rec. 8' mud Stal. 3162 Layton 3617  
Lans. 3664 Miss. 4412 Kh. 4748  
Viola 4818 Simp. 4833 DST 4826-56  
open 1 hr. Rec. 65' gcm & 400' hgcm  
510' sw TD 4856  
D & A