


Section 3 Township 35 Range 3-W

Well No. #3 Hobbisiefkin

Company Texas

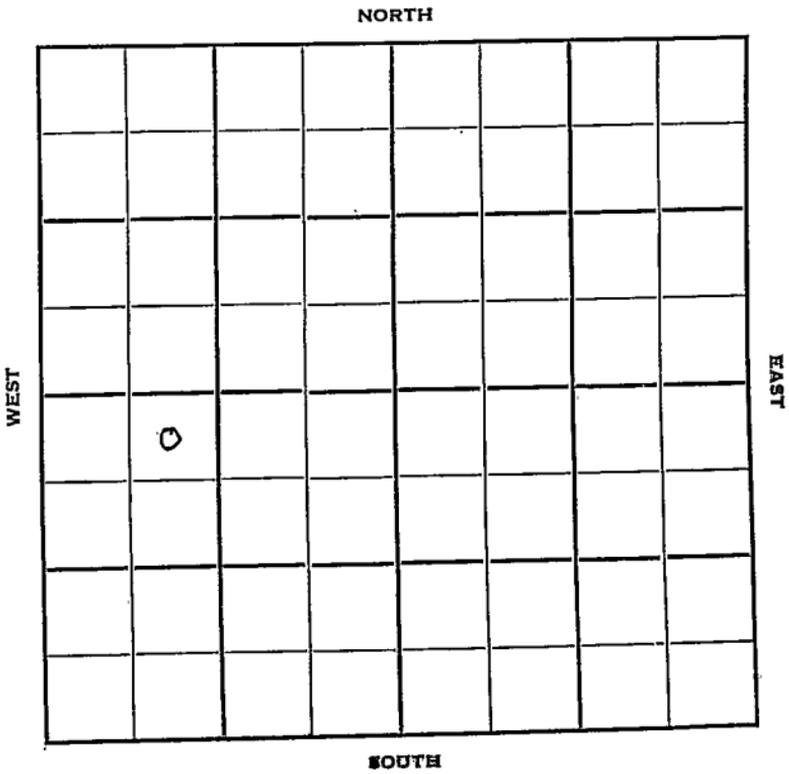

Sec. 3 Twp. 35 R. 3W

Well No. #3 Hobbisiefkin Farm

Texas Company

Stickel Bros Contractor

Fall Creek Pool


330' Ft. from N. Line

_____ Ft. from S. Line

_____ Ft. from E. Line

990' Ft. from W. Line

NE NW SW

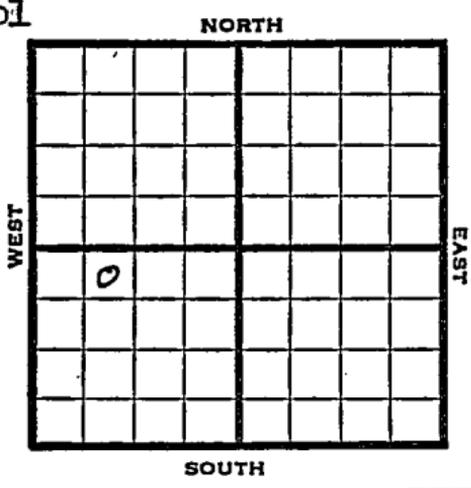

1950

Elev 1143' REPORT

9/20

MIR

11/15

Spud 9-25-50
 10" @ 604
 Stal 3120 Layton 3586
 KC 3640
 DST 3680-98 opn 2 hr rec 3250' gas
 210' go & gcm
 BHP 290#
 Miss 4323
 DST 4330-45 opn 45 min good blow rec
 50' gcm
 Kinderhook 4676 Viola 4724
 DST 4730-57 opn 1 hr rec 1700' gas
 45' mud SSO
 Cored 4757-77 2' dol. sat
 14' sand & sdy dol
 DST 4753-77 opn 1 hr rec 350' oil
 150' hocm
 TD 4777
 7" @ 4752
 S/32 bo 6 hr
 F/70 BO 2 hr
 F/23 boph
 CORRECTED TOPS:
 Kinderhook 4671 Viola 4721
 Simp 4732
 Comp 1337 bopd
 TD 4777'
 Completed



OVER

COMPLETED

1951
5/9

O. W. D. D

Oil well TD 4818'
Simp. 4732' 7" @ 4752' OTD 4777'
DD 4818' F/8-3/4 BOPH
25 gal Norflow A
Comp. F/276 BOPD

**FIRST REPORT
COMPLETED**

SEP 22 1958

Scout Cards
Land Small Map
Land Wall Map
Tracings
France Map
Pierce Map
Misc.


County Sumner State Kansas

Sec. 3 (Blk. 35 (Sur. 3W (Twp. 35 (Rge. 3W Map No.

Operator Texas

Well No. 3 Farm Hobbisiefkin

Elev. Location NE NW SW

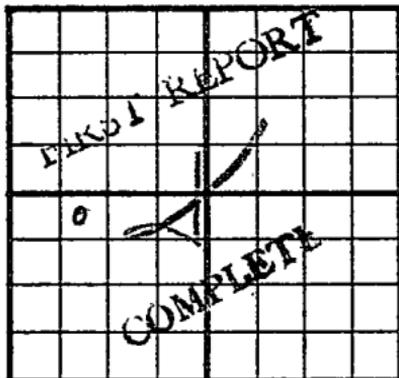

330 Ft. From N Line' SW

990 Ft. From W Line Quarter

lst. Report MAY 9 1951

Completion MAY 9 1951

Remarks OWDD

C. W. D. D

Spudding Date

Drlg. Data Oil well TD 4818 Fall Creek Pool

Simp. 4732 7" @ 4752 OTD 4777

DD 4818 F/ 8 3/4 boph 25 gal. Norflow A

Comp. F/ 276 bopd

Scout Cards	<i>mm</i>
Land Grant Map	
Land Grant Map	<i>3</i>
...	
...	
...	
...	

MAY 11 1951

Orig. Data