


WELL RECORD

1-35-30W

Mail to Kansas Geological Survey, 4150 Monroe Street, Wichita, Kansas 67209

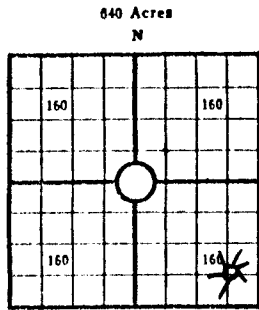

Lease Name: Adams Ranch Well No. 1
 Well Located: Meade County, Kansas
C SE SE SEC 1 TWP 35S RGE 30W
 Operator: Leben Oil Corporation
 Address: 200 West Douglas, Wichita, Kansas
 Elevation: Ground 2498 D.F. 2505 K.B. 2508
 Type Well: (Oil, gas, dry hole) Gas

(corrected 6/21/12)

Drilling Commenced: Aug. 7 19 71 Drilling Completed: Aug. 25 19 71
 Well Completed: Aug. 25 19 71 Total Depth 6460
 Initial Production: 2584 MCF GPD

Casing Record

Size: 8 5/8" Set at 1367' Size: Set at
 Size: Set at Size: Set at

production casing - 4 1/2" d.

Liner Record

Size: Set from To

Cementing

Casing Size	Sacks	Type Cement and Additives
<u>8 5/8"</u>	<u>500</u>	<u>50-50 Poz., 6% Gel., 2% Ca Cl</u>
<u> </u>	<u>200</u>	<u>2% CaCl</u>
<u> </u>	<u> </u>	<u> </u>

Perforations

Formation Perforated Interval and Number Shots

Electric Log Run (Show type log and depths covered)

FORMATION, TESTING AND CORRELATION
Show Drill Stem Tests,
Well Stimulation and
Production Tests

1-35-30w

Formation Top Bottom

Marmaton

Cherokee

Morrow

5808

Chester

5920

St. Geneiveve

6228

St. Louis

6329



0' - 70' surface soil & sand
70' - 570' sd - clay - red bed
570' - 1318' red bed
1318' - 1367' sh & anhy
1367' - 1375' anhy
1375' - 1790' red bed & shells
1790' - 2250' sh - shells
2250' - 2430' sh - anhy
2430' - 2602' sh - lm
2602' - 4090' lm & sh
4090' - 4295' sh - lm
4295' - 5061' lm - sh
5061' - 5410' lm
5410' - 5874' lm - sh
5874' - 5980' lm
5980' - 6170' lm - sh
6170' - 6192' lm - sh - sd
6192' - 6460' lm
6460' TD

Smp Tops

Heeb

4392

Tor

4427

LKC

4523

Hodges

5058

Mrm

5240

Cher

5465

LOG TOPS

Mrw

5808

Chest

5920

Chest Sd

6159

Ste Gen

6228

St Louis

6329

RTD

6462