


TOPOGRAPHIC ENGINEERING COMPANY

Surveying and Mapping for the Oil & Gas Industry

409 Regency Tower 333 N.W. 5th St. (405) 235-2363
Oklahoma City, Okla. 73102

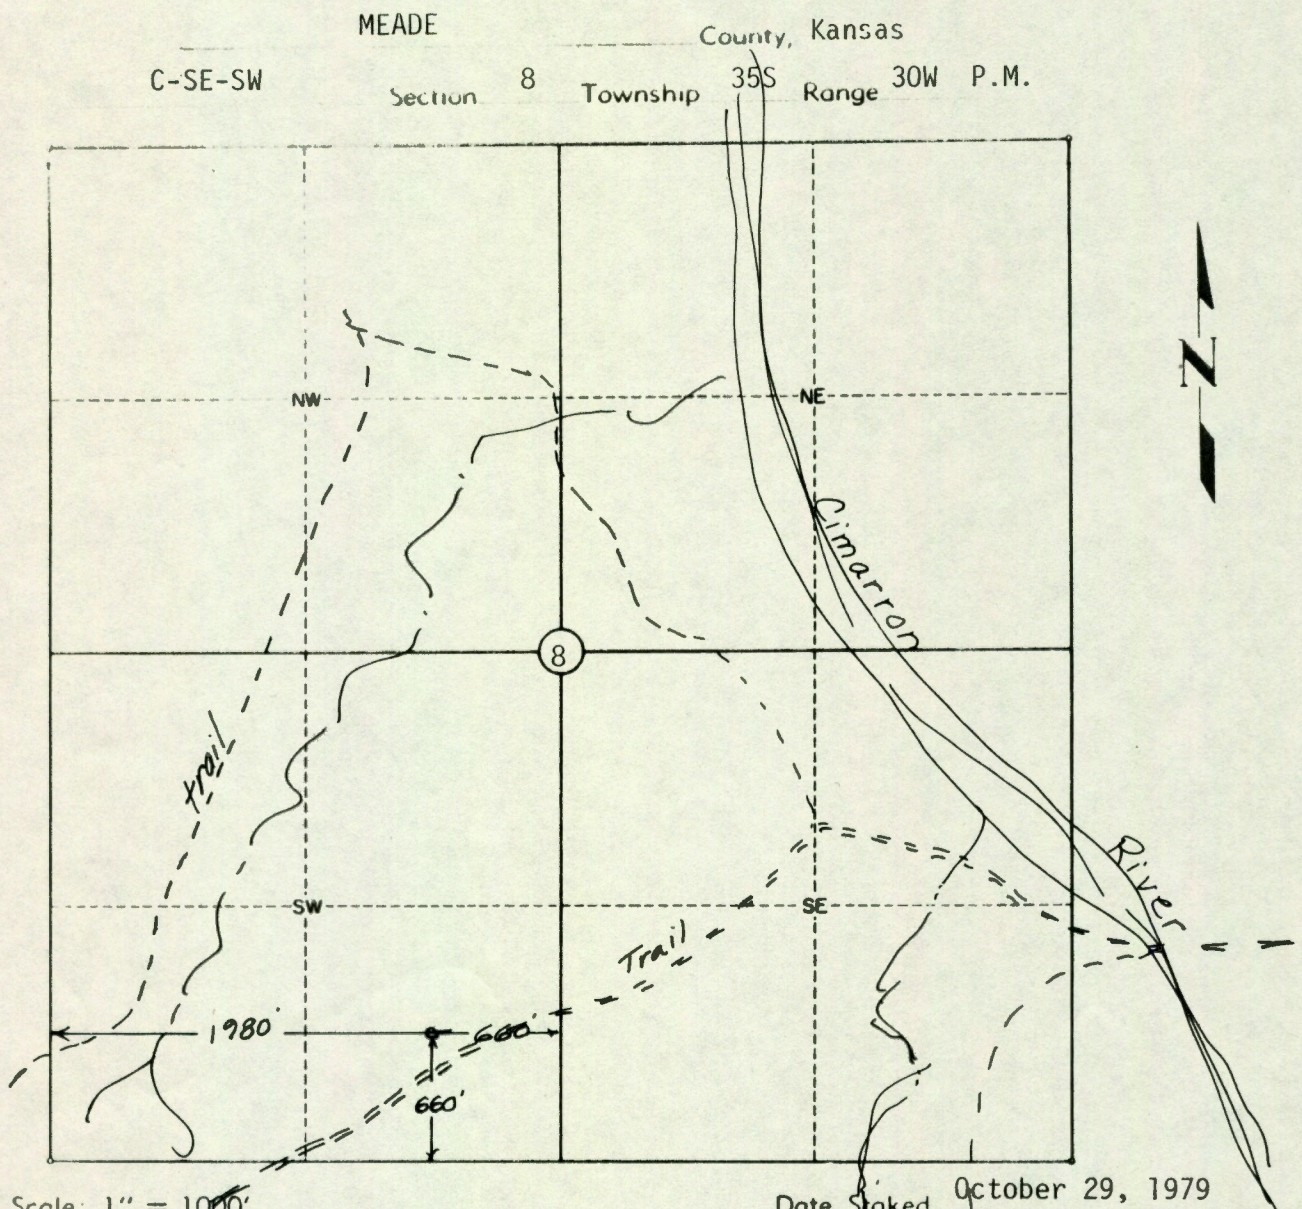

This location has been very carefully staked on the ground according to the best official survey records, maps, and photographs available to us, but its accuracy is not guaranteed.

Review this plat and notify us immediately of any possible discrepancy.

Operator: QUINQUE OIL & GAS PRODUCING COMPANY

Lease Name: Adams Well No.: 1-8

ELEVATION:

2496' Gr. at stake

Topography & Vegetation rolling pasture 150' North of road

Good Drill Site? yes Reference Stakes or Alternate Location Stakes Set none

Best Accessibility to Location from SW along existing road

Distance & Direction from Jct. US 64, 270, and SH 23, East of Forgan, go 7 miles West on US 64-270; then North 6.4 miles and 1/2 mile East on gravel roads; thence 1.6 miles Northeasterly on lease roads and trails to location in Sec.8-35S-30W.

CERTIFICATE:

I, Gary D. Boswell a Registered Land Surveyor and an authorized agent of Topographic Engineering Co., do hereby certify that the above described well location was surveyed and staked on the ground as shown herein.

Gary D. Boswell

Reg. No. 670