

KANSAS DRILLERS LOG

15-175-20370
12-35-31WAPI No. 15 — 175 — 20,390
County Number

Operator

B & B Farm Industries, Inc.

Address

P. O. Box 638, Spearman, Texas 79081

Well No.

#2

Lease Name

Larry

Footage Location

660 feet from XX (S) line 2397' feet from XX (W) line

Principal Contractor

Sage Drilling

Geologist

Joe Blair

Spud Date

1-10-79

Total Depth

3400'

P.B.T.D.

3061'

Date Completed

2-1-79

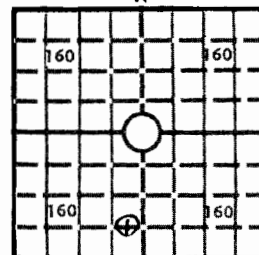
Oil Purchaser

Wait on Pipeline Connection

S. 12 T. 35S R. 31 XX
W

Loc. SE SW

County Seward

640 Acres
N

Locate well correctly

Elev.: Gr. 2662'

DF KB 2667'

CASING RECORD

Report of all strings set — surface, intermediate, production, etc.

Purpose of string	Size hole drilled	Size casing set (in O.D.)	Weight lbs/ft.	Setting depth	Type cement	Sacks	Type and percent additives
Surface	12-1/4"	8-5/8"	24#	1536'	Hall. lite Class "H"	600 150	2% CaCl 3% CaCl
Production	7-7/8"	5-1/2"	15.50#	3388'	Pozmix	200	18% salt .75% CFR-2

LINER RECORD

Top, ft.	Bottom, ft.	Sacks cement
None		

PERFORATION RECORD

Shots per ft.	Size & type	Depth interval
4 holes total	DML	3067 - 3069'
12 holes total	DML	3039 - 3045'

TUBING RECORD

Size	Setting depth	Packer set at
2-3/8"		None

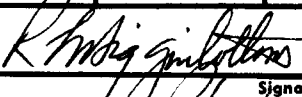
ACID, FRACTURE, SHOT, CEMENT SQUEEZE RECORD

Amount and kind of material used	Depth interval treated
250 gal. 15% MCA	3067 - 3069, squeezed
500 gals. 15% MCA	3039 - 3045'
2000 gals. 15% MOD 202	3039 - 3045'

INITIAL PRODUCTION

Date of first production		Producing method (flowing, pumping, gas lift, etc.)			
Jan. 28, 1979		Flow			
RATE OF PRODUCTION PER 24 HOURS	Oil	Gas	Water	Gas-oil ratio	
	- bbls.	421 MCF	- bbls.	- CFPB	
Disposition of gas (vented, used on lease or sold)			Producing interval (s)		
Wait on Pipeline Connection			3039 - 45'		

INSTRUCTIONS: As provided in KCC Rule 82-2-125, within 90 days after completion of a well, one completed copy of this Drillers Log shall be transmitted to the State Geological Survey of Kansas, 4150 Monroe Street, Wichita, Kansas 67209. Copies of this form are available from the Conservation Division, State Corporation Commission, 3830 So. Meridian (P.O. Box 17027), Wichita, Kansas 66217. Phone AC 316-522-2206. If confidential custody is desired, please note Rule 82-2-125. Drillers Logs will be on open file in the Oil and Gas Division, State Geological Survey of Kansas, Lawrence, Kansas 66044.

Operator B & B Farm Industries, Inc.		DESIGNATE TYPE OF COMP.: OIL, GAS, DRY HOLE, SWDW, ETC.:	
Well No. 2	Lease Name Larry		Gas
S <u>12</u> T <u>35</u> S <u>R31</u> ^{XX} _W			
WELL LOG		SHOW GEOLOGICAL MARKERS, LOGS RUN, OR OTHER DESCRIPTIVE INFORMATION.	
Show all important zones of porosity and contents thereof; cored intervals, and all drill-stem tests, including depth interval tested, cushion used, time tool open, flowing and shut-in pressures, and recoveries.			
FORMATION DESCRIPTION, CONTENTS, ETC.	TOP	BOTTOM	NAME
Shale, Sand and Anhydrite	1520	2632	
Dolomite, and Shale	2632	2982	Chase
Lime, Silt and Shale	2982	3326	Council Grove
Lime and Shale	3326	3400	T.D.
<div style="display: flex; justify-content: space-between;"> <div style="width: 40%;"> Welex Dual Induction G-Acous-Cal No Cores, No Tests </div> <div style="width: 60%;"></div> </div>			
USE ADDITIONAL SHEETS, IF NECESSARY, TO COMPLETE WELL RECORD.			
Date Received	<div style="text-align: right;">  Signature Petroleum Engineer Title April 16, 1979 Date </div>		