

"AMENDED"

SIDE ONE

1-35-32W

Under

KANSAS CORPORATION COMMISSION OF KANSAS
OIL & GAS CONSERVATION DIVISION

WELL COMPLETION OR RECOMPLETION FORM
ACO-1 WELL HISTORY

DESCRIPTION OF WELL AND LEASE

Operator: license # 5181
name Donald C. Slawson
address Suite 700, 20 N. Broadway
City/State/Zip Oklahoma City, OK 73102

Operator Contact Person Daniel G. Wilson
Phone 405 232-0201

Contractor: license # 5657
name Slawson Drilling Company

Wellsite Geologist Ed Heshner
Phone 806 374-5256

Type of Completion

☒ New Well ☐ Re-Entry ☐ Workover

☐ Oil ☐ SWD ☐ Temp Abd
☒ Gas ☐ Inj ☐ Delayed Comp.
☐ Dry ☐ Other (Core, Water Supply etc.)

if OWWO: old well info as follows:

Operator
Well Name
Comp. Date Old Total Depth

WELL HISTORY

Drilling Method: ☒ Mud Rotary ☐ Air Rotary ☐ Cable
Date 4/26/84 Date Reached TD 5/12/84 Completion Date 8/10/84

Total Depth 6,400' PBTD 6,332'

Length of Surface Pipe Set and Cemented at 1,524 feet

Multiple Stage Cementing Collar Used? ☐ Yes ☒ No

If Yes, Show Depth Set feet

If alternate 2 completion, cement circulated from feet depth to w/ SX cmt

API NO. 15-175-20,758
County Seward
SW SW SE Sec 1 Twp 35S Rge 32 East West

330 Ft North from Southeast Corner of Section
2310 Ft West from Southeast Corner of Section
(Note: locate well in section plat below)


Lease Name TUCKER Well# 2-1

Field Name Wildcat

Producing Formation Chester/Lower Morrow

Elevation: Ground 2,732' KB 2,738

Section Plat

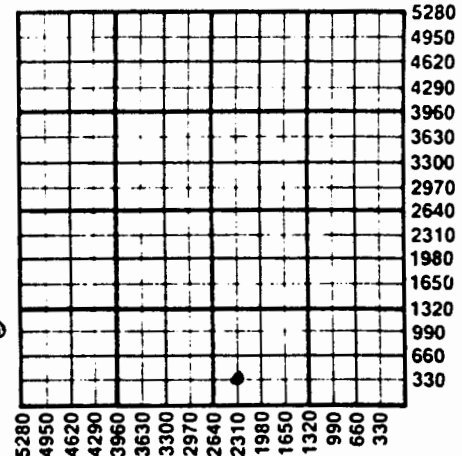

WATER SUPPLY INFORMATION

Source of Water:
Division of Water Resources Permit #
☒ Groundwater. Ft North From Southeast Corner and (Well) Ft. West From Southeast Corner of Sec Twp Rge East West
☐ Surface Water. Ft North From Southeast Corner and (Stream, Pond etc.). Ft West From Southeast Corner Sec Twp Rge East West
☐ Other (explain) (purchased from city, R.W.D.#)

Disposition of Produced Water: ☐ Disposal ☐ Repressuring

Docket #

INSTRUCTIONS: This form shall be completed in duplicate and filed with the Kansas Corporation Commission, 200 Colorado Derby Building, Wichita, Kansas 67202, within 90 days after completion or recompletion of any well. Rules 82-3-130 and 82-3-107 apply.

Information on side two of this form will be held confidential for a period of 12 months if requested in writing and submitted with the form. See rule 82-3-107 for confidentiality in excess of 12 months.

All wireline logs and drillers time log shall be attached with this form. Submit CP-4 form with all plugged wells. Submit CP-111 form with