

**STATE CORPORATION COMMISSION OF KANSAS  
OIL & GAS CONSERVATION DIVISION**

**WELL COMPLETION OR RECOMPLETION FORM  
ACO-1 WELL HISTORY**

**DESCRIPTION OF WELL AND LEASE**

**Operator:** license # 5703  
name J. M. Huber Corporation  
address 7120 I-40 West  
City/State/Zip Amarillo, Texas 79106

**Operator Contact Person** William D. Siddens  
Phone 806/353-9837

**Contractor:** license # 7860  
name Johnson Drilling Company, Inc.

**Wellsite Geologist** None  
Phone N/A

**PURCHASER** N/A

**Designate Type of Completion**

☒ New Well ☐ Re-Entry ☐ Workover

☐ Oil ☐ SWD ☐ Temp Abd  
☐ Gas ☐ Inj ☐ Delayed Comp.  
☒ Dry ☐ Other (Core, Water Supply etc.)

If **WO:** old well info as follows:

Operator  
Well Name  
Comp. Date Old Total Depth

**WELL HISTORY**

**Drilling Method:** ☒ Mud Rotary ☐ Air Rotary ☐ Cable

12-14-84 12-23-84 12-26-84  
Sp. Date Date Reached TD Completion Date

6300' 0'  
Total Depth PBTD

Amount of Surface Pipe Set and Cemented at 1505' feet

Multiple Stage Cementing Collar Used? ☐ Yes ☒ No

If Yes, Show Depth Set feet

If alternate 2 completion, cement circulated  
from feet depth to w/ SX cmt

**API NO.** 15 - 175-20,817

**County** Seward

**App.** C E/2 **Sec** 3 **Twp** 35S **Rge** 32 **East** X **West**

2660 Ft North from Southeast Corner of Section  
1550 Ft West from Southeast Corner of Section  
(Note: locate well in section plat below)


**Lease Name** Light "J" **Well#** 1

**Field Name** Liberal Light

**Producing Formation** None

**Elevation:** Ground 2775' KB 2787'

Section Plat

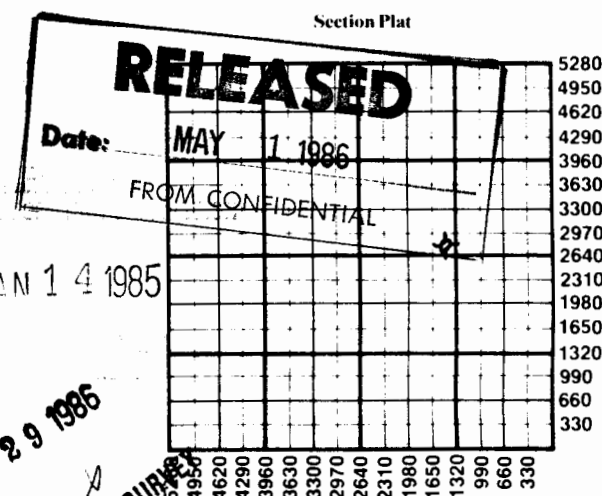

**WATER SUPPLY INFORMATION**

Source of Water:

Division of Water Resources Permit #

☐ Groundwater. Ft North From Southeast Corner and  
(Well) Ft West From Southeast Corner of

**Sec** **Twp** **Rge** ☐ East ☐ West

☐ Surface Water. Ft North From Southeast Corner and  
(Stream, Pond etc.). Ft West From Southeast Corner

**Sec** **Twp** **Rge** ☐ East ☐ West

☒ Other (explain) Purchased from Mr. Phil Light  
(surface and mineral owner)  
(purchased from city, H.W.D.#)

**Disposition of Produced Water:** ☐ Disposal ☐ Repressuring

**Docket #**

**INSTRUCTIONS:** This form shall be completed in duplicate and filed with the Kansas Corporation Commission, 200 Colorado Derby Building, Wichita, Kansas 67202, within 90 days after completion or recompletion of any well. Rules 82-3-130 and 82-3-107 apply.

Information on side two of this form will be held confidential for a period of 12 months if requested in writing and submitted with the form. See rule 82-3-107 for confidentiality in excess of 12 months.

One copy of all wireline logs and drillers time log shall be attached with this form. Submit CP-4 form with all plugged wells. Submit CP-111 form with all temporarily abandoned wells.

## SIDE TWO

Operator Name J. M. Huber Corp. Lease Name Light "J" Well# 1 SEC 3 TWP 35S RGE 32 ☐ East ☒ West

## WELL LOG

**INSTRUCTIONS:** Show important tops and base of formations penetrated. Detail all cores. Report all drill stem tests giving interval tested, time tool open and closed, flowing and shut-in pressures, whether shut-in pressure reached static level, hydrostatic pressures, bottom hole temperature, fluid recovery, and flow rates if gas to surface during test. Attach extra sheet if more space is needed. Attach copy of log.

Drill Stem Tests Taken

☐ Yes ☒ No

Samples Sent to Geological Survey

☒ Yes ☐ No

Cores Taken

☐ Yes ☒ No

## Formation Description

☒ Log ☐ Sample

Name	Top	Bottom
B/Heebner		4437'
Toronto	4462'	
Douglas	4482'	
Lansing	4540'	
Pleasanton Shale	5294'	
Marmaton	5304'	
Upper Oswego	5507'	
Lower Oswego	5540'	
Cherokee	5593'	
Novi	5708'	
Morrow	5900'	
Chester	6162'	

## CASING RECORD

☒ new ☐ used

Report all strings set - conductor, surface, intermediate, production, etc.

Purpose of string	size hole drilled	size casing set (in O.D.)	weight lbs/ft.	setting depth	type of cement	# sacks used	type and percent additives
Surface	12-1/4"	8-5/8"	24#	1505'	Class "A"	400	2 1/2% Lodense...
					Class "H"	200	1/4# celloflakes
							3% CaCl <sub>2</sub>

## PERFORATION RECORD

## Acid, Fracture, Shot, Cement Squeeze Record

shots per foot	specify footage of each interval perforated	(amount and kind of material used)	Depth