

WELL LOG BUREAU—KANSAS GEOLOGICAL SOCIETY

508 East Murdock,


Wichita, Kansas

11-35-32W

Company- JO-MILSON  
Farm- Light Est. "C" No. 1

SEC. 11 T. 35 R. 32W  
CNW NW

Total Depth. 6248'  
Comm. 10-2-53 Comp. 11-24-53  
Shot or Treated.  
Contractor. Unit Drlg. Co.  
Issued. 4-2-55

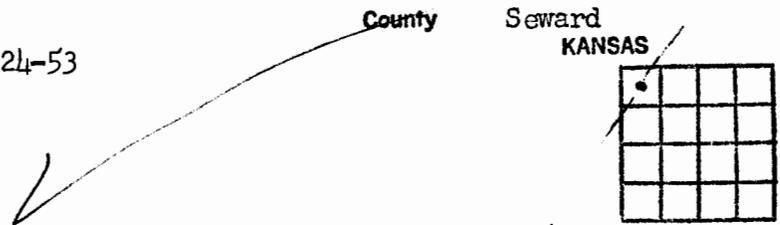

CASING:

13" 612'  
8 5/8" 2418'  
5 1/2" 5247'

Elevation. 2753'

Production. Dry

Figures Indicate Bottom of Formations.

sand-shale	630
red bed-shale	890
sand-lime	998
sand-shale	1460
shale-lime	1525
lime	1574
shale-lime	1722
shale-Anhydrite	1787
shale-lime	1846
shale	1908
shale-lime	2250
lime	2305
Anhydrite	2370
lime	2390
lime-shale	2435
lime	2545
shale-lime	2731
lime	2865
lime-shale	2900
lime	3236
lime-shale	3308
lime	3372
shale-lime	3468
lime	3990
lime-shale	4524
lime	5645
lime-sand	5679
shale	5730
lime-shale	5896
shale-sand	6016
lime	6039
shale-lime	6058
sand-shale	6081
lime-shale	6132
lime	6138
lime-shale	6235
lime	6248
Total Depth	

DST #4 - Set at 6053-6061. Tool open 30 min. Rec. 8' mud. No BHP,

DST #5 - 4876-4898. Rec. 8' gas cut mud. BHP 350# FP 0

DST #6 - 6127-Tool open 35 min. Closed 45 min. Rec. 40' mud. BHP-0 FP-0.

DST #1 - Came out of hole @ 6016 Packer did not hold. Pulled tool out.

DST #2 - came out @ 6058. Went in w/double packer. Packer did not hold.

DST #3 - Dual packer set 5847-5856. Tool open 1 hr. Pulled. Rec. 90' mud. No BHP. No FP Broke down testing tool.

SCHLUMBERGER TOPS: Scout  
Lansing 4598  
Marmaton 5295  
Morrow 5925