

*Handwritten initials*

STATE CORPORATION COMMISSION OF KANSAS  
OIL & GAS CONSERVATION DIVISION

WELL COMPLETION OR RECOMPLETION FORM  
ACO-1 WELL HISTORY

DESCRIPTION OF WELL AND LEASE

Operator: license # 5181  
name Donald C. Slawson  
address Suite 700, 20 N. Broadway  
City State Zip Oklahoma City, OK 73102

Operator Contact Person Daniel G. Wilson  
Phone 405 232-0201

Contractor: license # 5657  
name Slawson Drilling Company

Wellsite Geologist Ed Heshar  
Phone 806 374-5256

Describe Type of Completion  
 New Well  Re-Entry  Workover  
 Oil  SWD  Temp Abd  
 Gas  Inj  Delayed Comp.  
 Other (Core, Water Supply etc.)

If OWWO: old well info as follows:  
Operator  
Well Name  
Comp. Date Old Total Depth

WELL HISTORY

Drilling Method:  Mud Rotary  Air Rotary  Cable  
1/3/85 1/21/85 5/11/85  
Spur Date Date Reached TD Completion Date

6,650' 6,563'  
Total Depth PBTD

Amount of Surface Pipe Set and Cemented at 1,525 feet

Multiple Stage Cementing Collar Used?  Yes  No

If Yes, Show Depth Set feet

If alternate 2 completion, cement circulated from feet depth to w/ SX cmt

API NO. 15 - 175-20,824  
County Seward  
N/2 SE NE NE Sec 12 Twp 35S Rge 32  
(location)  
4480 Ft North from Southeast Corner of Sect  
330 Ft West from Southeast Corner of Sect  
(Note: locate well in section plat below)

Lease Name LOFLAND Well# 1-12


Field Name Wildcat

Producing Formation U. Morrow, L. Morrow & Chester

Elevation: Ground 2,732' KB 2,739'

*Handwritten:* JUN 14 1988  
State Geological Survey  
WICHITA BRANCH

Section Plat

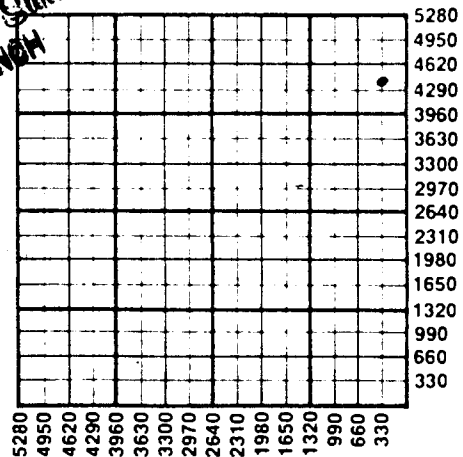

WATER SUPPLY INFORMATION

Source of Water:  
Division of Water Resources Permit #  
 Groundwater. Ft North From Southeast Corner (Well) Ft West From Southeast Corner  
Sec Twp Rge East West  
 Surface Water. Ft North From Southeast Corner (Stream, Pond etc.) Ft West From Southeast Corner  
Sec Twp Rge East West  
 Other (explain) (purchased from city, R.W.D.#)

Disposition of Produced Water:  Disposal  Repressuring

Docket #

INSTRUCTIONS: This form shall be completed in duplicate and filed with the Kansas Corporation Commission, 200 Colorado Derby Building Wichita, Kansas 67202, within 90 days after completion or recompletion of any well. Rules 82-3-130 and 82-3-107 apply.

Information on side two of this form will be held confidential for a period of 12 months if requested in writing and submitted with the form. See rule 82-3- for confidentiality in excess of 12 months.

One copy of all wireline logs and drillers time log shall be attached with this form. Submit CP-4 form with all plugged wells. Submit CP-111 form