

Amended

STATE CORPORATION COMMISSION OF KANSAS
OIL & GAS CONSERVATION DIVISION
WELL COMPLETION OR RECOMPLETION FORM
ACO-1 WELL HISTORY
DESCRIPTION OF WELL AND LEASE

Operator: License # 9152
Name Marexco
Address 10403 W. Colfax Ave. #680
Lakewood, CO 80215
City/State/Zip

Purchaser Gas - Shut-In

Operator Contact Person Stephen W. Marden
Phone 303-237-5716

Contractor: License # 6033
Name Murfin Drilling Company

Wellsite Geologist
Phone

Designate Type of Completion

☒ New Well ☐ Re-Entry ☐ Workover

☐ Oil ☐ SWD ☐ Temp Abd
☐ Gas ☐ Inj ☐ Delayed Comp.
☐ Dry ☐ Other (Core, Water Supply etc.)

OWWO: old well info as follows:

Operator
Well Name
Comp. Date Old Total Depth

WELL HISTORY

Drilling Method:

☒ Mud Rotary ☐ Air Rotary ☐ Cable
4-2-87 4-16-87
Spud Date Date Reached TD Completion Date
6800' 6510'
Total Depth PBD

8-5/8" @ 1645'

Amount of Surface Pipe Set and Cemented at.....feet
Multiple Stage Cementing Collar Used? Yes ☐ No ☐
If yes, show depth set.....4680.....feet
If alternate 2 completion, cement circulated
from.....4680.....feet depth to 3928' w/ 290. SX cmt
Cement Company Name Western Company of North America
Invoice # 35484

API NO. 15-...175-20,952

County Seward

220' N. NW. NW. Sec 16... Twp. 35S. Rge. 32... East
West

4840..... Ft North from Southeast Corner of Section
4620..... Ft West from Southeast Corner of Section
(Note: Locate well in section plat below)


Lease Name Winkler Well # 1-16

Field Name Three Start

Producing Formation Chester Sandstone

Elevation: Ground 2747' KB 2756'

Section Plat

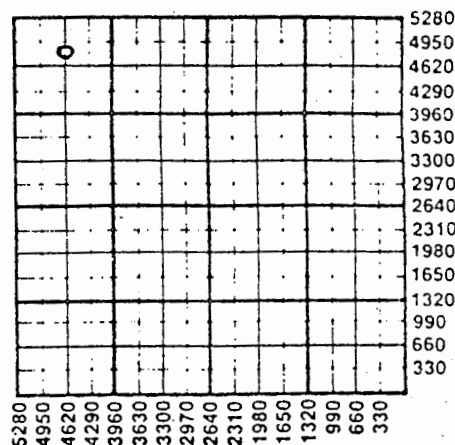

A

WATER SUPPLY INFORMATION

Disposition of Produced Water: Disposal
Docket # Repressuring

Questions on this portion of the ACO-1 call:

Water Resources Board (913) 296-3717

Source of Water: Well

Division of Water Resources Permit # J87-129

Groundwater 1980 Ft North from Southeast Corner
(Well) 1980 Ft West from Southeast Corner of
Well Sec 16 Twp 35 Rge 32 East ☒ West

Surface Water.....Ft North from Southeast Corner
(Stream, pond etc).....Ft West from Southeast Corner
Sec Twp Rge East West

Other (explain).....
(purchased from city, R.W.D. #)

INSTRUCTIONS: This form shall be completed in triplicate and filed with the Kansas Corporation Commission, 200 Colorado Derby Building, Wichita, Kansas 67202, within 120 days of the spud date of any well. Rule 82-3-130, 82-3-107 and 82-3-106 apply.

Information on side two of this form will be held confidential for a period of 12 months if requested in writing and submitted with the form. See rule 82-3-107 for confidentiality in excess of 12 months.

One copy of all wireline logs and drillers time log shall be attached with this form. Submit CP-4 form with all plugged wells. Submit CP-111 form with all temporarily abandoned wells.