

STATE CORPORATION COMMISSION OF KANSAS
OIL & GAS CONSERVATION DIVISION

WELL COMPLETION OR RECOMPLETION FORM
ACO-1 WELL HISTORY

DESCRIPTION OF WELL AND LEASE

Operator: License # 4549
Name Anadarko Petroleum Corporation
Address Box 351
City/State/Zip Liberal, Kansas 67901

Purchaser Undetermined

Operator Contact Person Paul Gatlin
Phone (316) 624-6253

Contractor: License # 7860
Name Johnson Drilling Company, Inc.

Wellsite Geologist William D. Copeland
Phone (417) 882-4190

Designate Type of Completion

☒ New Well ☐ Re-Entry ☐ Workover
☐ Oil ☐ SWD ☐ Temp Abd
☒ Gas ☐ Inj ☐ Delayed Comp.
☐ Dry ☐ Other (Core, Water Supply etc.)

If OWWO: old well info as follows:

Operator
Well Name
Comp. Date Old Total Depth

WELL HISTORY

Drilling Method:
☒ Mud Rotary ☐ Air Rotary ☐ Cable
9/3/85 9/19/85 11/15/85
Spud Date Date Reached TD Completion Date
6975 6390
Total Depth PBTD

Amount of Surface Pipe Set and Cemented at 1648 feet
Multiple Stage Cementing Collar Used? ☐ Yes ☒ No
If yes, show depth set feet
If alternate 2 completion, cement circulated
from feet depth to w/ SX cmt

SIDE ONE

API NO. 15-175-20,877

County Seward

SW NE Sec 17 Twp 35S Rge 34 ☐ East ☒ West

3450 Ft North from Southeast Corner of Section
1980 Ft West from Southeast Corner of Section
(Note: Locate well in section plat below)


Lease Name Grover "D" Well # 1

Field Name Wideawake

Producing Formation Chester

Elevation: Ground 2927 KB 2940

Section Plat

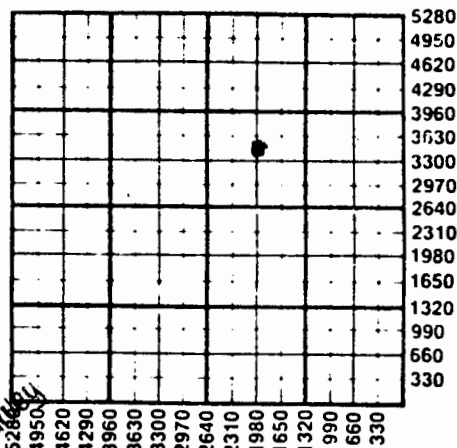

WATER SUPPLY INFORMATION

Disposition of Produced Water: ☐ Disposal ☐ Reinjecting

Questions on this portion of the ACO-1 call:
Water Resources Board (913) 296-3717

Source of Water:
Division of Water Resources Permit # T85-791

☒ Groundwater 3300 Ft North from Southeast Corner
(Well) 1980 Ft West from Southeast Corner of
Sec 17 Twp 35S Rge 34 ☐ East ☒ West

☐ Surface Water Ft North from Southeast Corner
(Stream, pond etc.) Ft West from Southeast Corner
Sec Twp Rge ☐ East ☐ West

☐ Other (explain)
(purchased from city, R.W.D. #)

INSTRUCTIONS: This form shall be completed in duplicate and filed with the Kansas Corporation Commission, 200 Colorado Derby Building, Wichita, Kansas 67202, within 90 days after completion or recompletion of any well. Rule 82-3-130 and 82-3-107 apply.

Information on side two of this form will be held confidential for a period of 12 months if requested in writing and submitted with the form. See rule 82-3-107 for confidentiality in excess of 12 months.

One copy of all wireline logs and drillers time log shall be attached with this form. Submit CP-4 form with