

RELEASED

SIDE ONE

11-35-34W

5/6/85
7-20-86
7/20/87
KCC
TIC

STATE CORPORATION COMMISSION OF KANSAS
OIL & GAS CONSERVATION DIVISION
FROM CONFIDENTIAL

WELL COMPLETION OR RECOMPLETION FORM
ACO-1 WELL HISTORY

DESCRIPTION OF WELL AND LEASE

Operator: License # 5469
Name Anadarko Production Co.
Address Box 351
City/State/Zip Liberal, Kansas 67901

Purchaser: Undetermined

Operator Contact Person Paul Gatlin
Phone (316) 624-6253

Contractor: License # 5842
Name Gabbert-Jones, Inc. STATE CORPORATION COMMISSION

Wellsite Geologist Greg Smith
Phone (303) 223-1842

Designate Type of Completion

New Well Re-Entry Workover

Oil SWD Temp Aband.
 Gas Inj Delayed Comp.
 Dry Other (Core, Water Supply etc.)

If OWMO: old well info as follows:

Operator
Well Name
Comp. Date Old Total Depth

WELL HISTORY

Drilling Method:
 Mud Rotary Air Rotary Cable
3/11/85 3/27/85 4/20/85
Spud Date Date Reached TD Completion Date
6915 6371
Total Depth PBTD

Amount of Surface Pipe Set and Cemented at 1605 feet
Multiple Stage Cementing Collar Used? Yes No
If yes, show depth set.....feet
If alternate 2 completion, cement circulated
from.....feet depth to.....w/.....SX cmt

CONFIDENTIAL

API NO. 15-175-20,838
County Seward
NE SE Sec. 11 Twp. 35S Rge. 34 East West

1980 Ft North from Southeast Corner of Section
330 Ft West from Southeast Corner of Section
(Note: Locate well in section plat below)

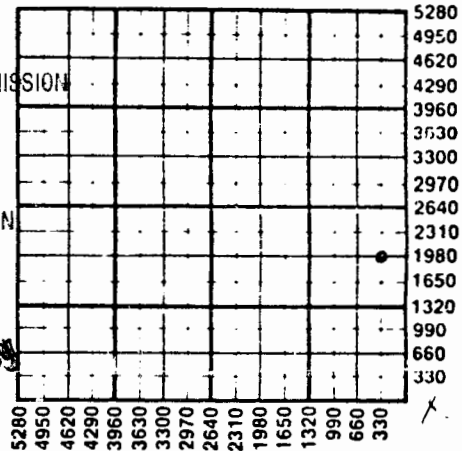
Lease Name Headrick "A" Well # 1

Field Name Wideawake

Producing Formation L. Morrow

Elevation: Ground 2894 KB. 2907

Section Plat



RECEIVED
MAY 06 1985
CONSERVATION DIVISION
Wichita, Kansas
MAY 07 1985
State Geological Survey
WICHITA BRANCH

WATER SUPPLY INFORMATION

Disposition of Produced Water: Disposal Repressuring
Docket #

Questions on this portion of the ACO-1 call:

Water Resources Board (913) 296-3717

Source of Water:
Division of Water Resources Permit #

Groundwater.....Ft North from Southeast Corner
(Well)Ft West from Southeast Corner of
Sec Twp Rge East West

Surface Water.....Ft North from Southeast Corner
(Stream, pond etc).....Ft West from Southeast Corner
Sec Twp Rge East West

Other (explain) Water bought from farmer...
(purchased from city, R.W.D. #)

INSTRUCTIONS: This form shall be completed in duplicate and filed with the Kansas Corporation Commission, 200 Colorado Derby Building, Wichita, Kansas 67202, within 90 days after completion or recompletion of any well. Rule 82-3-130 and 82-3-107 apply. Information on side two of this form will be held confidential for a period of 12 months if requested in writing and submitted with the form. See rule 82-3-107 for confidentiality in excess of 12 months. One copy of all wireline logs and drillers time log shall be attached with this form. Submit CP-4 form with all plugged wells. Submit CP-111 form with all temporarily abandoned wells.

W 48-28-1

SIDE TWO

Operator Name Anadarko Production Company Lease Name Headrick "A" Well # 1

Sec. 11 Twp. 35S Rge. 34 East West County Seward

WELL LOG

INSTRUCTIONS: Show important tops and base of formations penetrated. Detail all cores. Report all drill stem tests giving interval tested, time tool open and closed, flowing and shut-in pressures, whether shut-in pressure reached static level, hydrostatic pressures, bottom hole temperature, fluid recovery, and flow rates if gas to surface during test. Attach extra sheet if more space is needed. Attach copy of log.

Drill Stem Tests Taken [] Yes [x] No
Samples Sent to Geological Survey [x] Yes [] No
Cores Taken [] Yes [x] No

Formation Description [] Log [x] Sample

Schlumberger ran Dual Induction/SFL w/GR and Compensated Neutron/Lithodensity w/GR.

Table with 3 columns: Name, Top, Bottom. Rows include Cased Hole, Sand-Redbed, Sand-Redbed-Anhy, Sand-Redbed, Lime-Shale, Shale-Lime, Lime-Shale, TD.

Table with 6 columns: Oil, Gas, Water, Gas-Oil Ratio, Gravity. Row: Estimated Production Per 24 Hours.

METHOD OF COMPLETION

Production Interval

Disposition of gas: [] Vented [x] Sold [] Used on Lease [] Open Hole [x] Perforation [] Other (Specify) 6260-6276 OA (L. Morrow)

CASING RECORD [x] Dually Completed [] NEW [] USED

Report all strings set-conductor, surface, intermediate, production, etc.

Table with 8 columns: Purpose of String, Size Hole Drilled, Size Casing Set (in O.D.), Weight Lbs/Ft., Setting Depth, Type of Cement, #Sacks Used, Type and Percent Additives.

PERFORATION RECORD

Acid, Fracture, Shot, Cement squeeze Record

Table with 3 columns: Shots Per Foot, Specify Footage of Each Interval Perforated, (Amount and Kind of Material Used) Depth.

TUBING RECORD Size 2-3/8 Set At 6225 Packer at -- Liner Run [] Yes [x] No

Date of First Production Producing Method [x] Flowing [] Pumping [] Gas Lift [] Other (explain) SI WOPL

CONFIDENTIAL

GABBERT-JONES, INC.
DRILLERS WELL LOG

11-35-34W

HEADRICK "A" #1
1980' FSL & 330 FWL
Sec. 11-35S-34W
Seward County, Kansas
Commenced: 3-11-85

Completed: 3-28-85

Operator: ANADARKO PRODUCTION COMPANY

MAY 07 1985

State Geological Survey
WICHITA BRANCH

Depth		Formation	Remarks
From	To		
0	30	Cased hole	30' of 20" csg
30	860	Sand-Redbed	
860	1120	Sand-Redbed-Anhy	Ran 38 jts of 24# 8 5/8"
1120	1610	Sand-Redbed	LD @ 1605' w/600 sks Posmix
1610	1730	Lime-Shale	4% Gel-2% CC-200 sks
1730	2440	Shale-Lime	Common -2% CC
2440	6915	Lime-Shale	PD @ 3:00am 3-14-85

6915-TD

STATE GEOLOGICAL SURVEY
WICHITA BRANCH

AUG 17 1987

RECEIVED
STATE CORPORATION COMMISSION

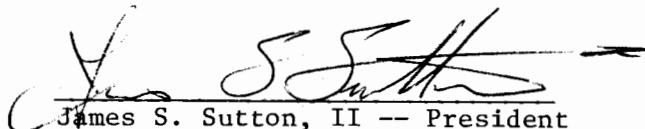
MAY 06 1985

CONSERVATION DIVISION
Wichita, Kansas

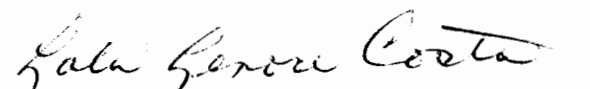
Ran 156 jts of 11.6# 4 1/2"
csg LD @ 6439' DV Tool
4530 - Bottom 50 sks Lite
230 sks 50/50 Posmix-10% Salt
.5% CFR2 - PD @ 8:00am
Top w/50sks Lite Wt-175 sks
50/50 Posmix - 10% Salt
5% CFR2 PD @ 1:30pm
3-28-85

State of Kansas)
) I, the undersigned, being duly sworn on oath, state
County of Sedgwick) that the above Drillers' Well Log is true and correct
) to the best of my knowledge and belief and according
) to the records of this office.

GABBERT-JONES, INC.


James S. Sutton, II -- President

Subscribed & sworn to before me this
20 day of April, 1985.


Lola Lenore Costa

My Commission expires November 21, 1988