

11-35-35W

STATE CORPORATION COMMISSION OF KANSAS
OIL & GAS CONSERVATION DIVISION
WELL COMPLETION OR RECOMPLETION FORM
ACO-1 WELL HISTORY
DESCRIPTION OF WELL AND LEASE

Operator: License # 5181
Name Donald C. Slawson
Address Suite 700, 20 N. Broadway
City/State/Zip Oklahoma City, OK 73102

Purchaser Prairie States Gas Company

Operator Contact Person Daniel G. Wilson
Phone 405/232-0201

Contractor: License # 5657
Name Slawson Drilling Company

Wellsite Geologist Ed Heshner
Phone 806/374-5256

Designate Type of Completion

☒ New Well ☐ Re-Entry ☐ Workover

☐ Oil ☐ SWD ☐ Temp Abd

☒ Gas ☐ Inj ☐ Delayed Comp.

☐ Dry ☐ Other (Core, Water Supply etc.)

If OWNED: old well info as follows:

Operator

Well Name

Comp. Date Old Total Depth.....

WELL HISTORY

Drilling Method:

☒ Mud Rotary ☐ Air Rotary ☐ Cable

12/26/85 1/5/86 2/1/86
.....

Spud Date Date Reached TD Completion Date

6,700 6,630
.....

Total Depth PBTD

Amount of Surface Pipe Set and Cemented at 1720 feet

Multiple Stage Cementing Collar Used? ☐ Yes ☒ No

If yes, show depth set.....feet

If alternate 2 completion, cement circulated

from.....feet depth to.....w/.....SX cmt

Cement Company Name

Invoice #

API NO. 15-.....189,20,896.....

County Stevens.....

C-SW SE NE Sec. 11 Twp. 35S Rge. 35 East
..... X West

2970
990 Ft North from Southeast Corner of Section
..... Ft West from Southeast Corner of Section

(Note: Locate well in section plat below)


Lease Name BARRELL Well # 1-11

Field Name Wildcat

Producing Formation Lower Morrow/Chester

Elevation: Ground 2,950 2,956 KB.....

Section Plat

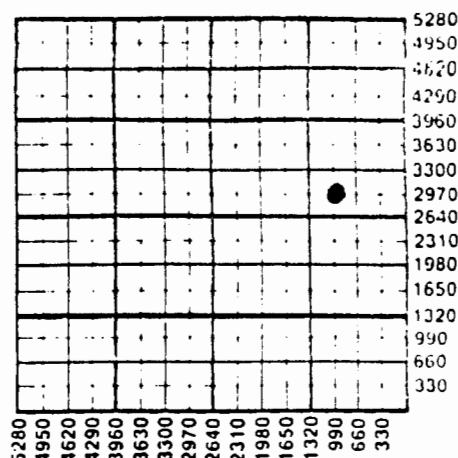

WATER SUPPLY INFORMATION

Disposition of Produced Water:

☐ Disposal

Docket #

☐ Repressuring

Questions on this portion of the ACO-1 call:

Water Resources Board (913) 296-3717

Source of Water:

Division of Water Resources Permit #.....

Groundwater.....Ft North from Southeast Corner
(Well)Ft West from Southeast Corner of

Sec Twp Rge East West

Surface Water.....Ft North from Southeast Corner
(Stream, pond etc).....Ft West from Southeast Corner

Sec Twp Rge East West

Other (explain).....

(purchased from city, R.W.D. #)

INSTRUCTIONS: This form shall be completed in triplicate and filed with the Kansas Corporation Commission, 200 Colorado Derby Building, Wichita, Kansas 67202, within 120 days of the spud date of any well. Rule 82-3-130, 82-3-107 and 82-3-106 apply.

Information on side two of this form will be held confidential for a period of 12 months if requested in writing and submitted with the form. See rule 82-3-107 for confidentiality in excess of 12 months.

One copy of all wireline logs and drillers time log shall be attached with this form. Submit CP-4 form with all plugged wells. Submit CP-111 form with all temporarily abandoned wells.