

6-35-39 W

PI

SIDE ONE

*Handwritten signature*

STATE CORPORATION COMMISSION OF KANSAS  
OIL & GAS CONSERVATION DIVISION

WELL COMPLETION OR RECOMPLETION FORM  
ACO-1 WELL HISTORY

DESCRIPTION OF WELL AND LEASE

Operator: License # 5469  
Name Anadarko Production Company  
Address Box 351  
City/State/Zip Liberal, Kansas 67901

Purchaser Panhandle Eastern Pipe Line Co.  
Liberal, Kansas 67901

Operator Contact Person Paul Gatlin  
Phone (316) 624-6253

Contractor: License # 5842  
Name Gabbert-Jones, Inc.

Wellsite Geologist None  
Phone

Designate Type of Completion  
 New Well  Re-Entry  Workover  
 Oil  SWD  Temp Abd  
 Gas  Inj  Delayed Comp.  
 Dry  Other (Core, Water Supply etc.)

If OWN: old well info as follows:

Operator  
Well Name  
Comp. Date Old Total Depth

WELL HISTORY

Drilling Method:  
 Mud Rotary  Air Rotary  Cable  
1/5/85 1/10/85 6/24/85  
Spud Date Date Reached TD Completion Date  
3035 3000  
Total Depth PBDT

Amount of Surface Pipe Set and Cemented at 648 feet  
Multiple Stage Cementing Collar Used?  Yes  No  
If yes, show depth set feet  
If alternate 2 completion, cement circulated from feet depth to w/ SX cmt

API NO. 15-129-20,737

County Morton

NE/4 Sec. 6 Twp. 35S Rge. 39  East  West

2690 Ft North from Southeast Corner of Section  
1250 Ft West from Southeast Corner of Section  
(Note: Locate well in section plat below)


Lease Name Millemon "A" Well # 1

Field Name Panoma Council Grove

Producing Formation Council Grove

Elevation: Ground 3327 KB 3332

Section Plat

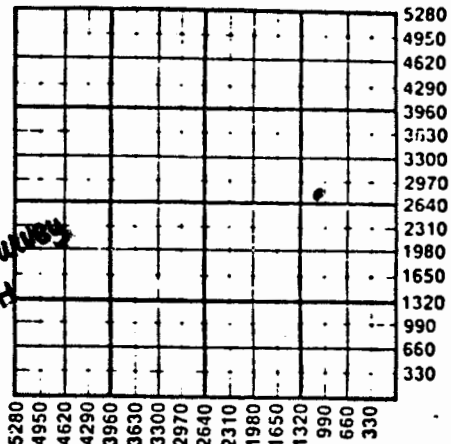

AUG 9 1 1985  
State Geological Survey  
WICHITA BRANCH

WATER SUPPLY INFORMATION

Disposition of Produced Water:  Disposal  Repressuring  
Docket # 100,905-C

Questions on this portion of the ACO-1 call:

Water Resources Board (913) 296-3717

Source of Water:  
Division of Water Resources Permit #

Groundwater.....Ft North from Southeast Corner (Well) .....Ft West from Southeast Corner of Sec Twp Rge  East  West

Surface Water.....Ft North from Southeast Corner (Stream, pond etc).....Ft West from Southeast Corner Sec Twp Rge  East  West

Other (explain) Hauled water from Hugoton, KS (purchased from city, R.W.D. #)

INSTRUCTIONS: This form shall be completed in duplicate and filed with the Kansas Corporation Commission, 200 Colorado Derby Building, Wichita, Kansas 67202, within 90 days after completion or recompletion of any well. Rule 82-3-130 and 82-3-107 apply.

Information on side two of this form will be held confidential for a period of 12 months if requested in writing and submitted with the form. See rule 82-3-107 for confidentiality in excess of 12 months.

One copy of all wireline logs and drillers time log shall be attached with this form. Submit CP-4 form with all plugged wells. Submit CP-111 form with all temporarily abandoned wells.

SIDE TWO

Operator Name Anadarko Production Company Lease Name Millemon "A" Well # 1

Sec. 6 Twp. 35S Rge. 39  East  West County Morton

WELL LOG

INSTRUCTIONS: Show important tops and base of formations penetrated. Detail all cores. Report all drill stem tests giving interval tested, time tool open and closed, flowing and shut-in pressures, whether shut-in pressure reached static level, hydrostatic pressures, bottom hole temperature, fluid recovery, and flow rates if gas to surface during test. Attach extra sheet if more space is needed. Attach copy of log.

Drill Stem Tests Taken  Yes  No  
 Samples Sent to Geological Survey  Yes  No  
 Cores Taken  Yes  No

Formation Description  
 Log  Sample

Gearhart ran Compensated Density Compensated Neutron Log, and Dual Induction Laterolog

Name	Top	Bottom
Sand	0'	661'
Redbed-Anhy	661'	1007'
Redbed, Anhy, Glorita		
Sand	1007'	1600'
Redbed, Anhy, Sand	1600'	1960'
Lime, Shale	1960'	3035'
TD	3035'	

Estimated Production Per 24 Hours	Oil	Gas	Water	Gas-Oil Ratio	Gravity
	0 Bbls	128 MCFD	18 Bbls	CFPB	

METHOD OF COMPLETION

Production Interval

Disposition of gas:  Vented  Open Hole  Perforation  
 Sold  Other (Specify) .....  
 Used on Lease

2917-91 OA

CASING RECORD  New  Used

Report all strings set-conductor, surface, intermediate, production, etc.

Purpose of String	Size Hole Drilled	Size Casing Set (in O.D.)	Weight Lbs/Ft.	Setting Depth	Type of Cement	#Sacks Used	Type and Percent Additives
Surface	12-1/4"	8-5/8"	20	648	Common	475	3% CaCl
Production	7-7/8"	4-1/2"	10.5	3035	Litewate	500	10% Salt
					Pozmix	150	.5% TF75

PERFORATION RECORD

Acid, Fracture, Shot, Cement Squeeze Record

Shots Per Foot	Specify Footage of Each Interval Perforated	(Amount and Kind of Material Used)	Depth
2	3004-3010	450 gal 15% HCL	3004-10
	3004-3010	Sqz 150 sxs Common	3004-10
2	2981-2993, 2972-77	1000 gal 15% HCL	2981-2977
2	2906-15, 2917-19, 2922-38, 2940-64	3750 gal 15% HCL + 170 BS	2906-2964
		Frac 104,400 gal slick wtr, 177,000# River sand	2906-2964

TUBING RECORD

Size 2-1/16 Set At 2913 Packer at ---

Liner Run  Yes  No

Date of First Production \_\_\_\_\_ Producing Method \_\_\_\_\_

Flowing  Pumping  Gas Lift  Other (explain).....

Millenon 'A' #1

6-35-394

P1

Perforation Record

Acid, Fracture, Shot, Cement Squeeze Record

Shots Per Foot	Specify Footage of Each Interval Perf	(Amt and Kind of Material Used)	Depth
4	2857-59	Sqz 400 sxs Common	2857-2964
2	2979-92		
2	2917-19, 2922-38, 2940-64	A/250 gal 15% HCL	2917-2964
		A/2550 gal 15% HCL + 100 BS	2917-2964
		Frac 44,000 gal Versa Gel, 74,000#	
		Riversand	2917-2964

AUG 0 1 1985  
State Geological Survey  
WICHITA BRANCH

RECEIVED  
STATE CORPORATION COMMISSION

JUL 10 1985  
CONSERVATION DIVISION  
Wichita, Kansas

P1

GABBERT-JONES, INC.  
DRILLERS WELL LOG

6-35-39W

MILLEMOM "A" #1  
2690' FNL & 1250' FEL  
Sec 6-35S-39W  
Morton County, Kansas

Commenced: 1-5-85

Completed: 1-10-85

Operator: ANADARKO PRODUCTION COMPANY

Depth		Formation	Remarks
From	To		
0	661	Sand	
661	1007	Redbed-Anhy	
1107	1600	Redbed, Anhy, Glorita Sand	Ran 15jts of 20#
1600	1960	Redbed, Anhy, Sand	8 5/8" csg set @
1960	3035	Lime, Shale	648' cemented w/475 sks Class H 3% CC PD @ 10:00 am 1-6-85


3035-TD

AUG 0 1 1985  
State Geological Survey  
WICHITA BRANCH

Ran 75 jts of 10 1/2 #  
4 1/2' csg set @ 3035'  
cemented W/500 sks  
Lite 150 sks 50/50  
posmix-10% Salt  
PD @ 11:00pm 1-10-85

State of Kansas )  
County of Sedgwick ) I, the undersigned, being duly sworn on oath, state  
that the above Drillers' Well Log is true and correct  
to the best of my knowledge and belief and according  
to the records of this office.

GABBERT-JONES, INC.

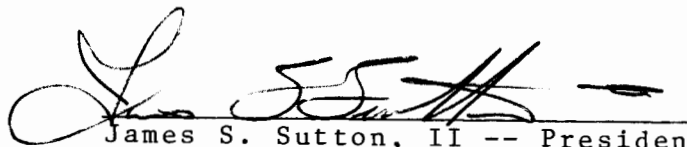  
James S. Sutton, II -- President

Subscribed & sworn to before me this  
15 day of January, 1985.

  
Lola Lenore Costa