

16-35-4 WP

STATE CORPORATION COMMISSION OF KANSAS
OIL & GAS CONSERVATION DIVISION

WELL COMPLETION OR RECOMPLETION FORM
ACO-1 WELL HISTORY

DESCRIPTION OF WELL AND LEASE

Operator: License # 4494
Name Clifford Resources, Inc.
Address 630 N.E. 63rd Street
City/State/Zip Okla. City, OK 73105

Purchaser Mid Plains

Operator Contact Person Dan Reineke
Phone (405) 840-1418

Contractor: License # 6333
Name DaMac Drilling, Inc.

Wellsite Geologist
Phone

Designate Type of Completion

☒ New Well ☐ Re-Entry ☐ Workover

☒ Oil ☐ SWD ☐ Temp Abd
☐ Gas ☐ Inj ☐ Delayed Comp.
☐ Dry ☐ Other (Core, Water Supply etc.)

If OWWO: old well info as follows:

Operator
Well Name
Comp. Date Old Total Depth

WELL HISTORY

Drilling Method:

☒ Mud Rotary ☐ Air Rotary ☐ Cable

2-13-86 2-25-86 3-21-86
Spud Date Date Reached TD Completion Date
5231' 5196'
Total Depth PBTD

Amount of Surface Pipe Set and Cemented at 281 feet
Multiple Stage Cementing Collar Used? ☐ Yes ☐ No
If yes, show depth set feet
If alternate 2 completion, cement circulated
from feet depth to w/ SX cmt

API NO. 15-191-21,893

County Sumner

SW SW Sec. 16 Twp 35S Rge. 4 ☐ East ☒ West

660 Ft North from Southeast Corner of Section
4620 Ft West from Southeast Corner of Section
(Note: Locate well in section plat below)


Lease Name Hedrick Well # 1-16

Field Name Hula

Producing Formation Simpson

Elevation: Ground 1207' KB 1217'

Section Plat

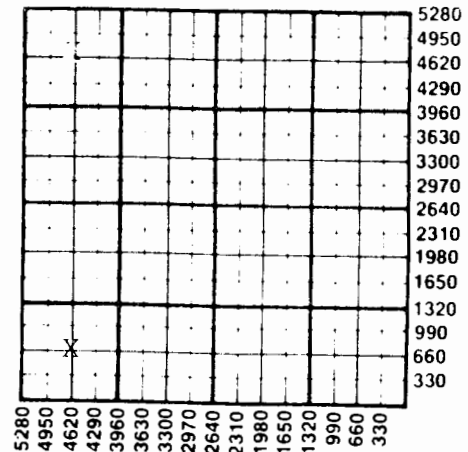

WATER SUPPLY INFORMATION

Disposition of Produced Water: ☐ Disposal ☐ Reinjecting
Docket #

Questions on this portion of the ACO-1 call:
Water Resources Board (913) 296-3717

Source of Water:
Division of Water Resources Permit #

☐ Groundwater Ft North from Southeast Corner (Well) Ft West from Southeast Corner of Sec Twp Rge ☐ East ☐ West

☐ Surface Water Ft North from Southeast Corner (Stream, pond etc) Ft West from Southeast Corner Sec Twp Rge ☐ East ☐ West

☐ Other (explain) (purchased from city, R.W.D. #)

INSTRUCTIONS: This form shall be completed in duplicate and filed with the Kansas Corporation Commission, 200 Colorado Derby Building, Wichita, Kansas 67202, within 90 days after completion or recompletion of any well. Rule 82-3-130 and 82-3-107 apply.

Information on side two of this form will be held confidential for a period of 12 months if requested in writing and submitted with the form. See rule 82-3-107 for confidentiality in excess of 12 months. One copy of all wireline logs and drillers time log shall be attached with this form. Submit CP-4 form with all plugged wells. Submit CP-111 form with all temporarily abandoned wells.