


Form 51-5M-2-29-34703

Map No. *Stevens* *sec 4* *37* *35* *37*^W
KANSAS Sec. Twp. R.

Well No. *1-Wiley* Farm

Argue Gas Company

NORTH

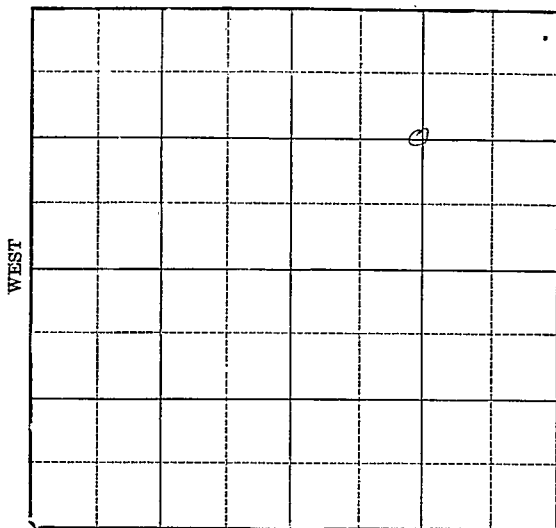

SOUTH

Location

Drilling Remarks

Rig Up

Drilling Remarks

RECORD

Cased in. ft.

Sand

Gas

Oil

Total Depth

PRODUCTION

1st 24 hrs. Nat.

1st 24 hrs. after shot


Gas cu. ft.

Dry Hole

Abandoned

Map No. 34 sec 4 KANSAS Sec. 35 Twp. 37 R.Well No. 1- Wesley FarmArgus Gas Company

NORTH

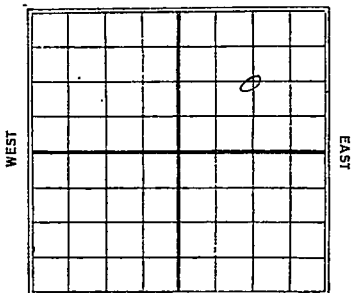1320 Ft. from N. Line

Ft. from S. Line

1320 Ft. from E. Line

Ft. from W. Line

1930

Date

REPORT

7/9 Loc

7/16

7/23 Rign up

7/30 Hdlg. 480'

8/6 " 1755'

8/13 " 2367'

8/20 " 8" 2550'

8/27 Rust

9/3

9/10

9/17 Sand 2550-2830

TD 2830

4 1/4 M gas
Pump.


Stevens
Map No. KANSAS Sec. 4 Twp. 35 R. 27 41

Well No. 1211

Agua Gas Company

J. J. Lewis Contractor

SECTION PLAT

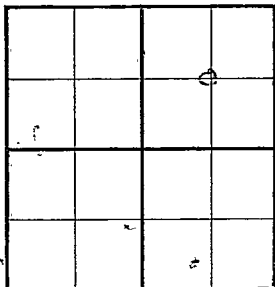

1320 Ft. from N. Line

_____ Ft. from S. Line

1320 Ft. from E. Line

_____ Ft. from W. Line

CORRECTION

Location _____

Rig up _____

Drilling and Remarks:

*Reported in
Sec 84.*

RECORD

Cased _____ in., _____ ft.

Sand _____

Gas _____

Oil _____

Total Depth _____

PRODUCTION

1st 24 hrs. Nat. _____

1st 24 hrs. after shot _____

Gas _____ Cu. Ft.

Dry Hole _____

Abandoned _____

Date

JUL 16 1930

S. J. LEWIS Scout

Map No. KANSAS Sec. 24 Twp. 25 R. 27 WWell No. 1 WileyArgus Gas Company

Contractor


SECTION PLAT

1820 Ft. from N. Line

..... Ft. from S. Line

1820 Ft. from E. Line

..... Ft. from W. Line

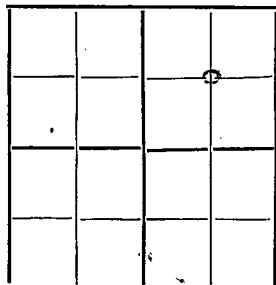

FIRST REPORTS

Location ✓

Rig up

Drilling and Remarks:

RECORD

Cased.....in.,ft.

Sand.....

Gas.....

Oil.....

Total Depth.....

PRODUCTION

1st 24 hrs. Nat.....

1st 24 hrs. after shot.....

Gas..... Cu. Ft.

Dry Hole.....

Abandoned.....

Date

JUL 9 1930 92 S. J. LEWIS Scout

Map No. KANSAS Sec. 4 Twp. 35 R. 37 W

Well No. 1820

Company Organic Gas

Contractor

SECTION PLAT

1820 Ft. from N. Line

_____ Ft. from S. Line

1820 Ft. from E. Line

_____ Ft. from W. Line

COMPLETED

Location _____

Rig up _____

Drilling and Remarks:

RECORD

Cased _____ in., _____ ft.

Sand 2.550 - 2830

Gas 4 1/4 M

Oil _____

Total Depth 2831

PRODUCTION

1st 24 hrs. Nat. _____

1st 24 hrs. after shot _____

Gas _____ Cu. Ft.

Dry Hole _____

Abandoned _____

Date

SEP 17 1930

S. J. LEWIS Scout