

KANSAS

Section 4 Township 35 Range 36W
Well No. #3 Dooch (*Gooch*)
Company Northern Natural Gas

Hugoton Pool

NORTH

WEST

EAST

				O			

SOUTH

KANSAS

Stevens

Sec. 4 Twp. 35 R. 36W

Well No. #3 Dooch Farm

Northern Natural Gas Company


Hugoton Pool

200' Ft. from N. Line

Ft. from S. Line

Ft. from E. Line

200' Ft. from W. Line

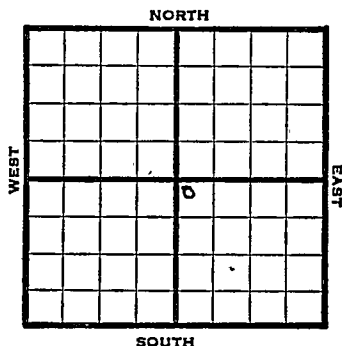

NW SE

1948 Elev. 3051' REPORT

2/18 Surface Hole

2/25 10" @ 701'
Drlg. 2446'

3/3 7" @ 2662'
TD 2671'

3/10 "

3/17 "

3/24 "

3/31 "

4/7 "

4/14 "

4/21 TD 2801'
157' of 5" Perf Liner

4/28 14000 acid.

5/5 7" @ 2663'
157' of 5" Perf liner @ 2801
Acid 14,000
Gas 27,425,000
R. Pr. 415#
TD 2801'

COMPLETED

Map No. _____ Sec. 4 Twp. 35 R. 36W

Well No. 3 Dooch

Northern Natural Gas Company

FIRST REPORT

Contractor _____

NW SE

SECTION PLAT

200 Ft. from N. Line

_____ Ft. from S. Line

_____ Ft. from E. Line

200 Ft. from W. Line

		0	

Stevens County

Location _____

Rig up _____

Drilling and Remarks:

surface hole

RECORD

Cased _____ in., _____ ft.

Sand _____

Gas _____

Oil _____

Total Depth _____

PRODUCTION

1st 24 hrs. Nat. _____

1st 24 hrs. after shot _____

Gas _____ Cu. Ft.

Dry Hole _____

Abandoned _____

Date

FEB 18 1948 19 _____ S. J. LEWIS Scout

Map No. _____ Sec. 4 Twp. 35 R. 36W

Well No. 3 Dooch

_____ Northern Natural Gas _____ Company

COMPLETE

_____ Contractor

NW SE


E. 3051
SECTION PLAT

200 Ft. from N. Line

_____ Ft. from S. Line

_____ Ft. from E. Line

200 Ft. from W. Line

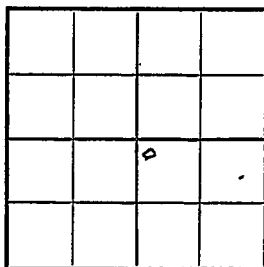

Stevens County

Location _____

Rig up _____

Drilling and Remarks:

7" C 2668

157' of 5" Perf liner

C 2801

14000 cu ft

27,425,000 gal

415# R/P

RECORD

Cased _____ in., _____ ft.

Sand _____

Gas _____

Oil _____

Total Depth 2801

PRODUCTION

1st 24 hrs. Nat. _____

1st 24 hrs. after shot _____

Gas _____ Cu. Ft.

Dry Hole _____

Abandoned _____

Date

MAY 5 1948 19

S. I. LEWIS Scout