


Seward KANSAS

SECTION 4 TOWNSHIP 35S RANGE 32W

WELL NO. #1 Pinegor

COMPANY Graham-Michaelis *C NE*  
~~C N/2 SW~~

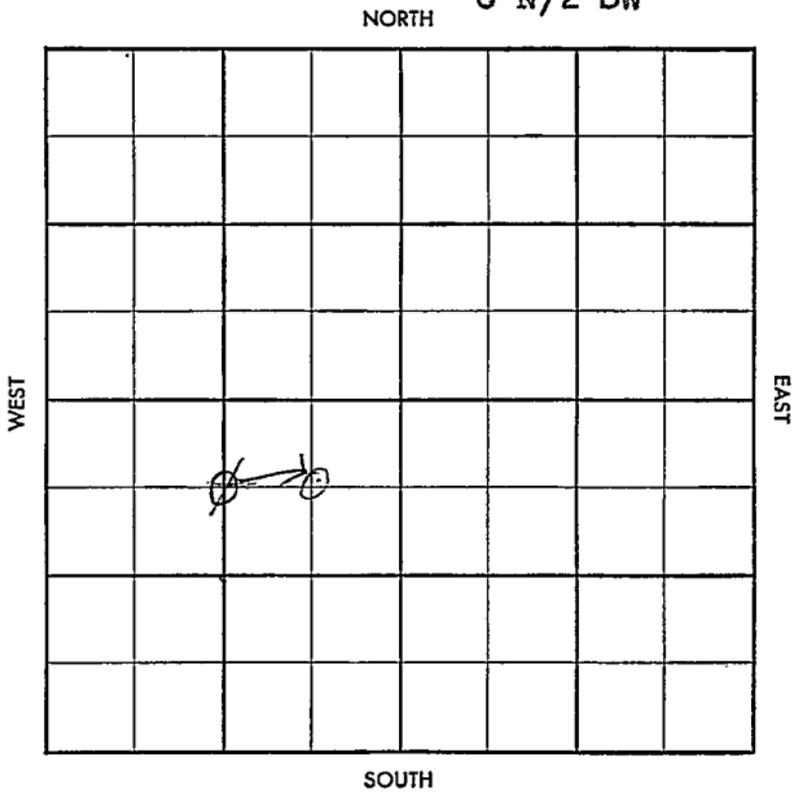


Twp. ~~Pool~~ X  
~~Pool~~ 2/2

S-513-B

County Seward Elev. \_\_\_\_\_  
 Sec. 4 Twp. 35 Rge. 32W  
 Company Graham-Michaelis  
 Farm Name Pinegor No. 1

TOPS	DEPTH	LOG	DATUM
Anh.			
Tp.			
H.			
Tr.			
Dg.			
B.L.			
L.			
K.C.			
B.K.C.			
Ce.			
C.			
M.			
M.			
K.			
Mz.			
Mq.			
V.			
S.			
S.			
A.			
R.			
Pf.			
G.			
T.D.			

Loc. in Sec. \_\_\_\_\_  
C N $\frac{1}{2}$  SW  
 Geol. \_\_\_\_\_  
 Contr. \_\_\_\_\_  
Co. tools  
 Pool \_\_\_\_\_  
Liberal Light

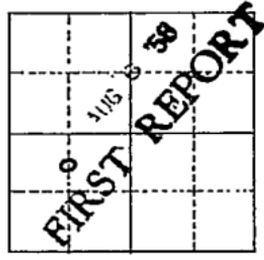

Date Comm. M I R

\_\_\_\_\_

\_\_\_\_\_

\_\_\_\_\_

\_\_\_\_\_

\_\_\_\_\_

\_\_\_\_\_

Co.  
 Lse.  
 No.  
 Sec.  
 T.  
 R.

**CORRECTION**

Top 11 Pool 100  
 3  
 2A

S-513-B

County Seward Elev. 177  
 Sec. 4 Twp. 35 Rge. 32W  
 Company Craban-Michaelis  
 Farm Name Pinecor No. 1

TOPS	DEPTH	LOG	DATUM
Antr. <u>Counal</u>	<u>3230</u>		
Tp.			
H.			
Tr.	<u>4438</u>	<u>4424</u>	
Dg.			
B.L.			
L.	<u>4580</u>	<u>4578</u>	
K.C. <u>Mar</u>		<u>5255</u>	
B.K.C.			
Ce.		<u>5474</u>	
C. <u>Mar</u>		<u>5822</u>	
M. <u>Chester</u>		<u>6082</u>	
M.			
K.			
Mz.			
Mq.			
V.			
S.			
S.			
A.			
R.			
Pf.			
G.			
T.D.	<u>6210</u>	<u>6197</u>	

Loc. in Sec. C 18 53  
CNESW

Geol. \_\_\_\_\_  
 Contr. \_\_\_\_\_  
 Co. tools \_\_\_\_\_  
 Pool \_\_\_\_\_  
 Liberal Light

**ABANDONED**

\* 0  
 SEP 3 '58

Date Comm. 8-5-58 Shell D.H.M. center "1" AC  
 AUG 13 '58 8" 1543/550 φ 2923  
 AUG 20 '58 φ 4719 AUG 27 '58 φ 5699  
 SEP 3 '58

D to A