


Section 4 Township 35S Range 3W

Well No. #1 Swain

Company G. & W. Alabama

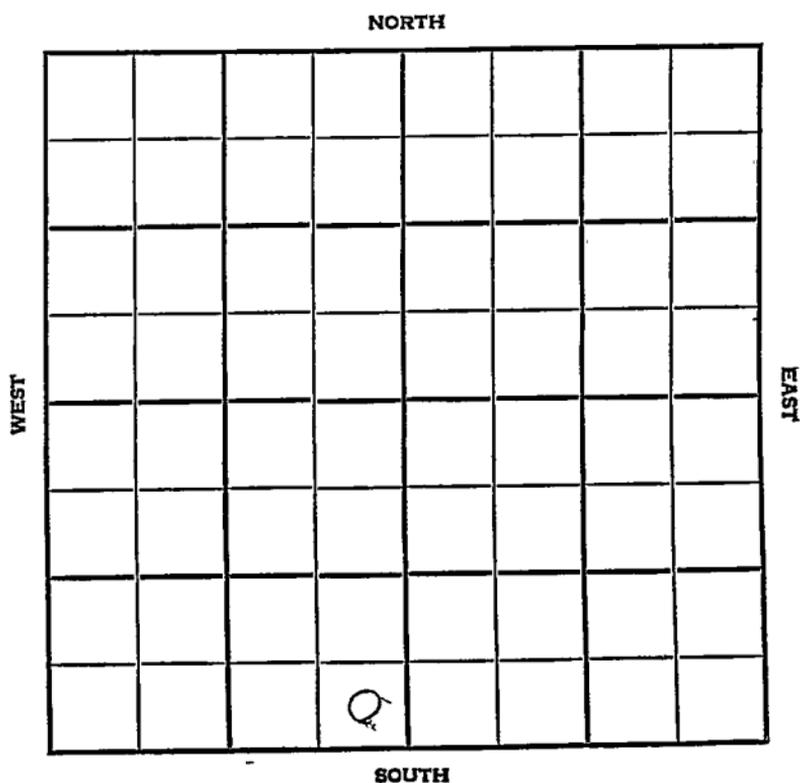

Summer

KANSAS

SEC. 4	TWP. 35S	R. 3W
-----------	-------------	----------

WELL NO.

1 Swain FARM
COMPANY

G & W, Alabama
CONTRACTOR

rig #3 Smitherman
Fall Creek


_____ FT. FROM N. LINE

_____ FT. FROM S. LINE

_____ FT. FROM E. LINE

_____ FT. FROM W. LINE

SE SE SW

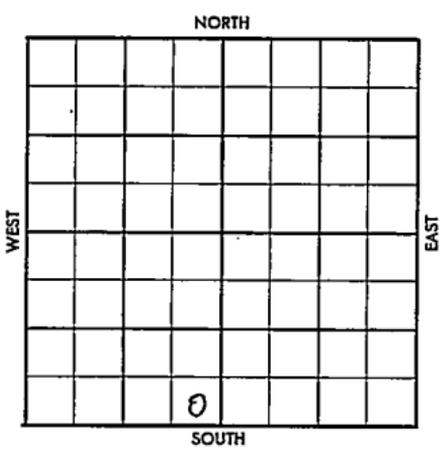

1956	ELEVATION	REPORT
------	-----------	--------

6-20		Comm. 6-16-56 8" @ 600 w/300, Drlg. 1289'
------	--	---

County Sumner Elev. _____
 Sec. 1 Twp. 35S Rge. 3W
 Company G & W Alabama
 Farm Name Straight No. 1

TOPS	DEPTH	LOG	DATUM
Anh.			
Tp.			
H.			
Tr.			
Dg.			
Bl.			
L.			
K.C.			
B.K.C.			
Ce.			
C.			
M.			
M.			
K.			
Mz.			
Me.			
V.			
S.			
S.			
A.			
R.			
PE.			
G.			
T.D.			

Loc. in Sec. SE SE SW
 Geol. _____
 Contr. rig #3
Smithman
 Pool _____
Fall Creek

FIRST REPORT

Date Comm. 6/15/56 JUN 20 '56
800 600 7/300, 3 1200

[Handwritten signature]

REF 2 S NUL
[Handwritten mark]

Co.
 P
 Loc.
 No.
 Sec.
 T.
 R.

County Sumner Elev. 1149
 Sec. 4 Twp. 35S Rge. 3W
 Company G & W, Alabama
 FarmName Swain No. 1

TOPS	DEPTH	LOG	DATUM	Loc. in Sec.
Anh.				SE SE SW
Tp.				
H.				
Tr.				
Dg.				
Bl.				
L.				
K.C.	<u>3673</u>			Geol.
B.K.C.				Contr. rig #3
Ce.				Sm' therman
C.				
M.	<u>4385</u>			Pool
M.				Fall Creek
K.				
Mz.				
Mo.				
V.	<u>4793'</u>			ABANDON
S.	<u>4807</u>			
S.				
A.				
R.				SEP 26 '56
PE.				
G.				
T.D.	<u>5081</u>			

Date Comm. 6/16/56
8" 600 W/300, D 7289 JUN 27 '56 @ 3204
JUL 3 '56 @ 4402 JUL 11 '56 CR9 @ 4749
JUL 18 '56 @ 4956 JUL 25 '56 5 1/2 4890
AUG 1 '56 MICT AUG 8 '56 ✓ Tite
AUG 15 '56 AUG 22 '56 ✓ AUG 29 '56 ✓ SEP 5 '56
SEP 19 '56 SEP 26 '56 16/4794-98
20/4816-15 Frag Lost Load

DBA ✓