


Section 4 Township 35 Range 3 W

Well No. #2 Peters

Company Texas

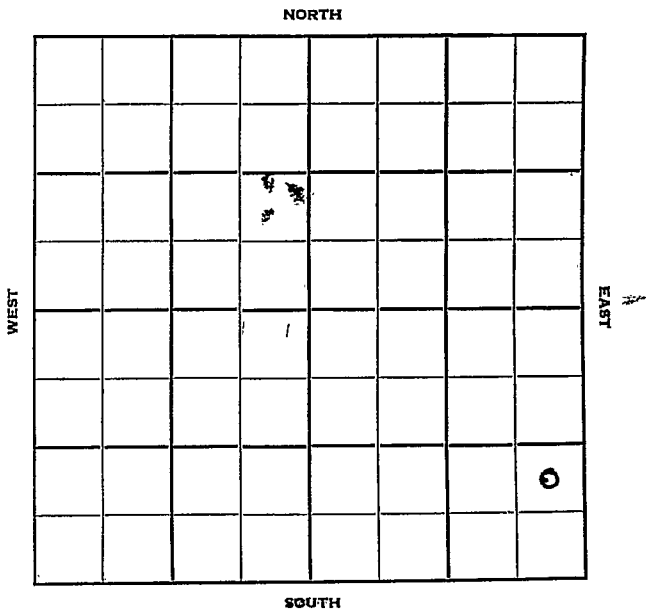

Sec. 4 Twp. 35 R. 3W

Well No. #2 Peters Farm

Texas Company

Stickle Drlg. -Contr. Contractor


Fall Creek Pool

\_\_\_\_\_ Ft. from N. Line

990' Ft. from S. Line

330' Ft. from E. Line

\_\_\_\_\_ Ft. from W. Line

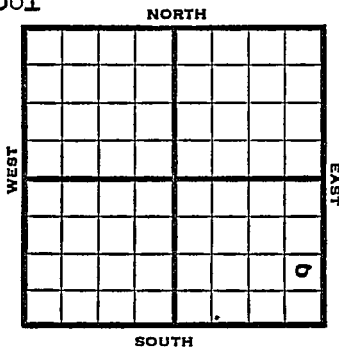

NE SE SE

1951

Elev. 1116' REPORT

1/24 Spud 1-18-51  
10" @ 581'  
Drlg. 1240'

3/28 Spud 1-18-51  
Oil Well TD 4770  
10" @ 531'  
KC 3616 Miss 4302  
Kinderhook 4654 Misenor 4703  
Viola 4708 Simp 4723  
Sand 4750-70  
7" @ 4747 42/4722-36  
F/48 boph 1000 A 4748-70  
1000 A @ 4722-36  
F/28 boph Comp. 3000 bopd Gr. 46

**COMPLETED**



