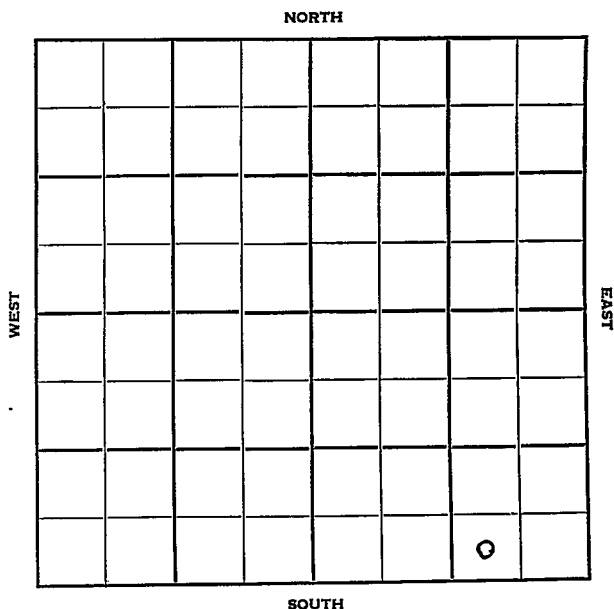


Section 4 Township 35 Range 3 WWell No. # 3 PetersCompany Texas

Summer

KANSAS 3W ✓

Sec. 4 Twp. 35 R. 3W

Well No. #3 Peters Farm

Texas Company

Stickle Drlg. - Contr. Contractor

Fall Creek Pool

 Ft. from N. Line

330'


 Ft. from S. Line

990'

 Ft. from E. Line

 Ft. from W. Line

SW SE SE

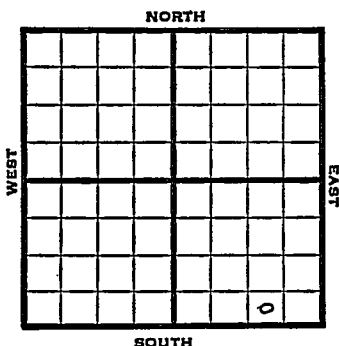

1951

Elev. 1126' REPORT

3/28

Cellar & Pits

5/16

Spud 3-29-51

Oil Well TD 4822

10" @ 605

KC 3638

Miss 4318

Kinderhook 4671 Misenor 4719

Viola 4733

Simp. 4748

Sand 4788

DST 4747-4815 opn 36 min. hole full of oil

DST 4800-22 opn 1 hr Rec. 315'

ho & gcm 7" @ 4816 TD 4822

24/4757-63

28/4773-80

24/4784-90

24/4795-4801

2000 A

F/42 boph

Comp. 2176 bopd

COMPLETED

J. E. TYRA

J. E. TYRA