

KANSAS DRILLERS LOG

API No. 15 — 129 — 20336
 County Number

S. 10 T. 35 R. 43 ^E_W
 Loc. SW NE
 County Morton

Operator
 Pan Eastern Exploration Company

Address
 P. O. Box 828, Liberal, Kansas 67901


Well No. 1 Lease Name Jones

Footage Location
 1980 feet from (N) line 1980 feet from (E) line

Principal Contractor Geologist

Spud Date Total Depth P.B.T.D.

Date Completed Oil Purchaser

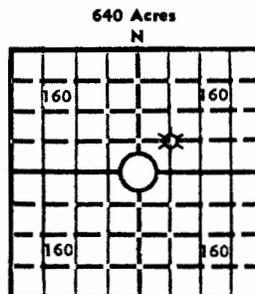

Elev.: Gr. _____
 DF _____ KB _____

CASING RECORD

Report of all strings set — surface, intermediate, production, etc.

Purpose of string	Size hole drilled	Size casing set (in O.D.)	Weight lbs/ft.	Setting depth	Type cement	Sacks	Type and percent additives
<p>AMENDED REPORT</p> <p>This report is a supplement to our report on 1/18/78. It is to correct the location of the well in the section.</p>							

LINER RECORD

PERFORATION RECORD

Top, ft.	Bottom, ft.	Sacks cement	Shots per ft.	Size & type	Depth interval
TUBING RECORD					
size	Setting depth	Packer set at			

ACID, FRACTURE, SHOT, CEMENT SQUEEZE RECORD

Amount and kind of material used	Depth interval treated

INITIAL PRODUCTION

Date of first production	Producing method (flowing, pumping, gas lift, etc.)				
RATE OF PRODUCTION PER 24 HOURS	Oil	Gas	Water	Gas-oil ratio	
	bbls.	MCF	bbls.	CFPB	
Disposition of gas (vented, used on lease or sold)			Producing interval (s)		

INSTRUCTIONS: As provided in KCC Rule 82-2-125, within 90 days after completion of a well, one completed copy of this Drillers Log shall be transmitted to the State Geological Survey of Kansas, 4150 Monroe Street, Wichita, Kansas 67209. Copies of this form are available from the Conservation Division, State Corporation Commission, 3830 So. Meridian (P.O. Box 17027), Wichita, Kansas 66217. Phone AC 316-522-2206. If confidential custody is desired, please note Rule 82-2-125. Drillers Logs will be on open file in the Oil and Gas Division, State Geological Survey of Kansas, Lawrence, Kansas 66044.

IMPORTANT
Kans. Geo. Survey request
samples on this well.

15-129-20336

API No. 15 — 129 — 20,336
County Number

S. 10 T. 35 R. 43 ^R/_W
Loc. SW SW NE
County Morton

Operator
Pan Eastern Explorations Company

Address
P. O. Box 828 Liberal, Kansas 67901


Well No. # 1 Lease Name Jones

Footage Location
2310 feet from (N) ~~W~~ line 2310 feet from (E) ~~W~~ line

Principal Contractor Gabbert-Jones, Inc. Geologist --

Spud Date December 14, 1977 Total Depth 3062' P.B.T.D.

Date Completed January 5, 1978 Oil Purchaser --

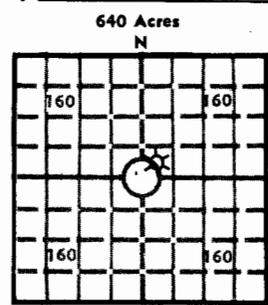

Elev.: Gr. 3618'
DF KB

CASING RECORD

Report of all strings set — surface, intermediate, production, etc.

Purpose of string	Size hole drilled	Size casing set (in O.D.)	Weight lbs/ft.	Setting depth	Type cement	Sacks	Type and percent additives
Surface	12-1/4"	8-5/8"	24#	408'	Common	350	3% HA-5
Production	7-7/8"	4-1/2"	9.5#	3058'	Pozmix	150	Salt sat w/2% CFR-2

LINER RECORD

PERFORATION RECORD

Top, ft.	Bottom, ft.	Sacks cement	Shots per ft.	Size & type	Depth interval
			2 SPF	DP	2668-74, 2642-48
TUBING RECORD			2 SPF	DP	(2948-52, 2906-14,
					(2874-93, 2864-68,
Size <u>1-1/2"</u>	Setting depth <u>Not installed</u>	Packer set at			(2842-48, 2826-28

ACID, FRACTURE, SHOT, CEMENT SQUEEZE RECORD

Amount and kind of material used	Depth interval treated
Acidized w/750 gals 15% Dolotrol acid w/20 ball sealers	2668-74 & 2642-48
Acidized w/12,000 gals West Pad & 10,000 gal 15% Dolotrol - 140 ball sealers	All perforations

INITIAL PRODUCTION

Date of first production	Producing method (flowing, pumping, gas lift, etc.) <u>Flowing</u>			
RATE OF PRODUCTION PER 24 HOURS	Oil <u>0</u> bbls.	Gas <u>400</u> MCF	Water <u>5</u> bbls.	Gas-oil ratio <u> </u> CFPB
Disposition of gas (vented, used on lease or sold) <u>to be sold</u>			Producing interval(s) <u>Greenwood Series</u>	

INSTRUCTIONS: As provided in KCC Rule 82-2-125, within 90 days after completion of a well, one completed copy of this Drillers Log shall be transmitted to the State Geological Survey of Kansas, 4150 Monroe Street, Wichita, Kansas 67209. Copies of this form are available from the Conservation Division, State Corporation Commission, 3830 So. Meridian (P.O. Box 17027), Wichita, Kansas 66217. Phone AC 316-522-2206. If confidential: custody is desired, please note Rule 82-2-125. Drillers Logs will be on open file in the Oil and Gas Division, State Geological Survey of Kansas, Lawrence, Kansas 66044.

Operator

Pan Eastern Exploration Company

DESIGNATE TYPE OF COMP.: OIL, GAS, DRY HOLE, SWDW, ETC.:

Well No.

#1

Lease Name

Jones

Gas

S 10 T 35 S R 43 E W

WELL LOG

Show all important zones of porosity and contents thereof; cored intervals, and all drill-stem tests, including depth interval tested, cushion used, time tool open, flowing and shut-in pressures, and recoveries.

SHOW GEOLOGICAL MARKERS, LOGS RUN, OR OTHER DESCRIPTIVE INFORMATION.

FORMATION DESCRIPTION, CONTENTS, ETC.

TOP

BOTTOM

NAME

DEPTH

See attached

USE ADDITIONAL SHEETS, IF NECESSARY, TO COMPLETE WELL RECORD.

Date Received

Jack P. Phillippe

Signature

Manager, Anadarko Basin Region

Title

1-18-78

Date

