


Section 5 Township 35 Range 42 W

Well No. #1 Pat-Mac

Company Colorado O & G

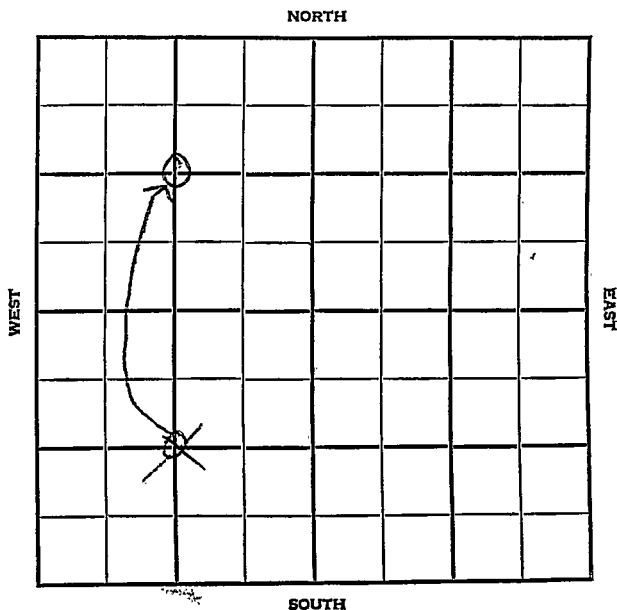

Morton

KANSAS

SEC. 5	TWP. 35	R. 42W
-----------	------------	-----------

WELL NO.

#1 Pat-Mac

FARM

COMPANY

Colorado Oil & Gas

CONTRACTOR

Holm Drlg.


Taloga

Ft. from N. Line

Ft. from S. Line

Ft. from E. Line

Ft. from W. Line

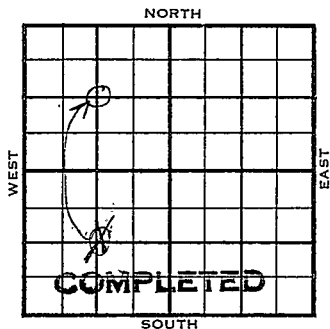C SW/4
NW/4

ELEVATION

REPORT

1956

2-8

Comm. 2-5-56

County Moxton Elev. _____
 Sec. 5 Twp. 35 Rge. 42W
 Company Colorado Oil & Gas
 FarmName Pat-Mac No. 1

TOPS	DEPTH	LOG	DATUM
Anh.			
TP.			
H.			
Tr.			
Dg.			
Bl.			
L.			
K.C.			
B.K.C.			
Ce.			
C.			
M.			
M.			
K.			
Mz.			
Mq.			
V.			
S.			
S.			
A.			
R.			
PE.			
G.			
T.B.			

Loc. in Sec. _____

C SW/4

Geol. _____

Contr. _____

Holm Drilg.

Pool _____

Taloga

FIRST REPORT

FEB 8 '56

Date Comm.

2-5-56

811 ©

24

CORRECTION

County Morton Elev. 3556
 Sec. 5 Twp. 35 Rge. 42W
 Company Colorado Oil & Gas
 Farm Name Rat-Mac No. 1

TOPS	DEPTH	LOG	DATUM	Loc. in Sec.
Anh. <u>W36</u>		<u>2656</u>		<u>C SW 1/4 NW 1/4</u>
Tp. <u>Le ep</u>		<u>3088</u>		
H. <u>Tp</u>		<u>2962</u>		
Tr. <u>Elm</u>		<u>2886</u>		
Dg.				Geol.
Bl.				Contr.
L.				<u>Holm Drlg.</u>
K.C.				Pool
B.K.C.				<u>Taloga</u>
Ce.				
C.				
M.				
M.				
K.				
Mz.				
Ma.				
V.				
S.				
S.				
A.				
R.				
PC.				
G.				

Date Comm. 2-5-56 MAR 7 1956

8" @ FEB 15 '56 8 5/8 604/400

5 1/2 @ ~~3132~~ / 200 FEB 22 '56 CO 3107

68/2970-87 3 1/2 + 51 L 200 MCF

P/g @ 2956 20/2937-42 52/

2909-22 28/2897-2904

9a 4,200 MCF CO 3107

9a 4 MCF FEB 29 '56 72-20

15.8 MCF 51P 420 FT MAR 7 '56