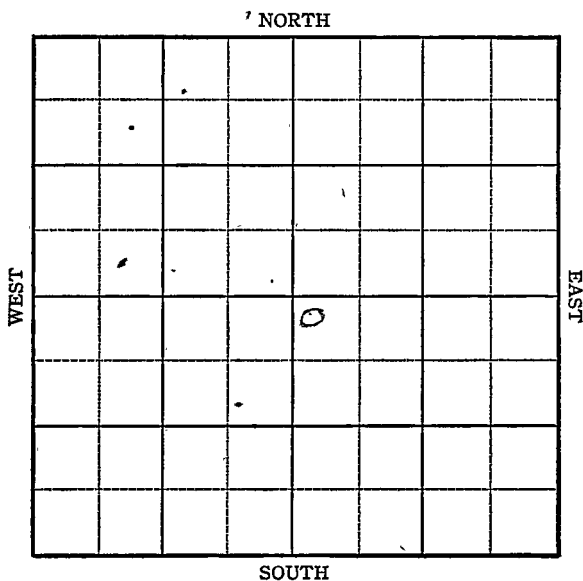


KANSAS

Stevens

FORM 51 5M PETROL

Section 5 Township 35 Range 35WWell No. 1 JennisonCompany Texas etal

KANSAS

Stevens

Sec. 5 Twp. 35 R. 35-W

Well No. #1 Jennison Farm

Texas etal Company


240 Ft. from N. Line

 Ft. from S. Line

 Ft. from E. Line

240 Ft. from W. Line

NW SE Elev. 2994

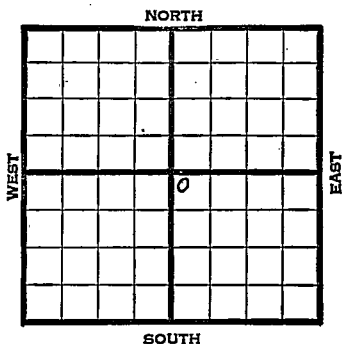

1945

REPORT

8/22 Location
8/29 10" @ 680
Drlg. 1490
9/5 Drlg. 2700
9/12 Blaine 952
Holenberg 2652
Herington 2676
Krider 2704
Winefield 2763
Ft. Riley 2818
Florence 3004
TD 3014
7" @ 2849' RUST
9/19 192 shots 2763-2795
300 acid. 2 M Gas
252 shots 2705-2745
Testing
9/26 4000 acid, 5 M gas
Plug 2694
10/3 8000 acid. 5½ M Gas
10/10 " " " "
10/17 " " " "
10/24 7" @ 2849
Perf. 15000 acid.
TD 3014'
15,800,000 Gas.
438# R Pr.

COMPLETED

KANSAS

Pool Name Hugoton

Map No. no map Sec. 5 Twp. 35 R. 35W

Well No. 1 Jennison

Texas etal Company

FIRST REPORT

Contractor

NW SE

SECTION PLAT

240 Ft. from N. Line

_____ Ft. from S. Line

_____ Ft. from E. Line

240 Ft. from W. Line

		0	

Stevens County

Location X

Rig up _____

Drilling and Remarks:

RECORD

Cased _____ in., _____ ft.

Sand _____

Gas _____

Oil _____

Total Depth _____

PRODUCTION

1st 24 hrs. Nat. _____

1st 24 hrs. after shot _____

Gas _____ Cu. Ft.

Dry Hole _____

Abandoned _____

Date

AUG 22 1945 19 S. J. LEWIS Scout

KANSAS

Pool Name HugotonMap No. 200 ^{Kansas} Sec. 5 Twp. 35 R. 35WWell No. 1 JennisonTexas etal

Company


COMPLETED

Contractor

NW SE

E1,2994

SECTION PLAT

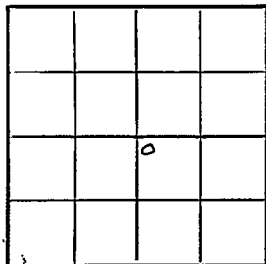240 Ft. from N. Line Ft. from S. Line Ft. from E. Line240 Ft. from W. LineStevens County

Location

Rig up

Drilling and Remarks:

7" 02548Perf.1500000015,500,000 Gas438 R 1/2**RECORD**Cased in., ft.Sand Gas Oil Total Depth 3014**PRODUCTION**1st 24 hrs. Nat. 1st 24 hrs. after shot Gas Cu. Ft.Dry Hole Abandoned

Date

OCT 24 194519S. J. LEWISScout