


FORM 51 25M 8-50 WESTERN **KANSAS** Seward
Section 5 Township 35 Range 34-W
Well No. #3 Dowdy
Company Plains Natural

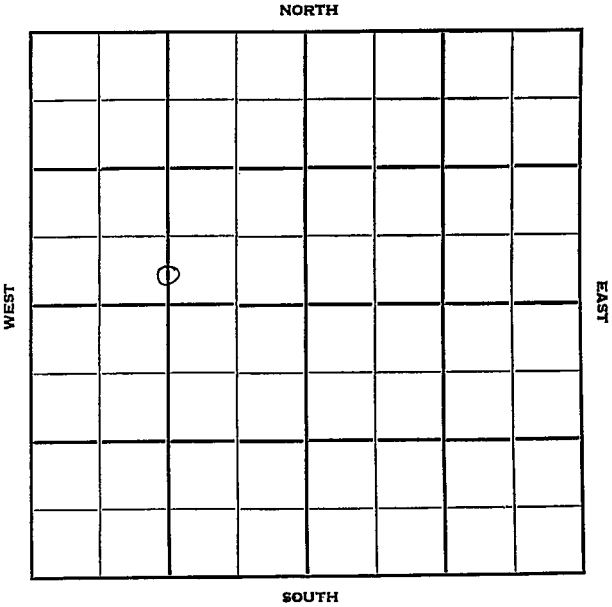

KANSAS
35

Seward

34-1

Sec. 5 Twp. 35 R. 34-1

Well No. #3 Dowdy Farm

Plains Natural Company

Hugoton Contractor


2440 Ft. from N. Line

 Ft. from S. Line

 Ft. from E. Line

1320 Ft. from W. Line

C S $\frac{1}{2}$ S $\frac{1}{2}$ NW

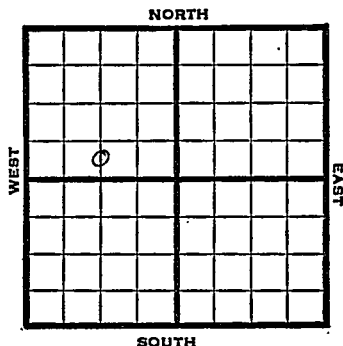

1950 Elev 2936 REPORT

10/11 Spud 10-8-50
10" @ 643

WOC

11/15 Spud 10-8-50
10" @ 643

Ho1 2572

Her 2633

Krider 2665

TD 2738

7" @ 2734


210/2696-2731, 60/2667-77, 120/2635-55

13000 A

Comp 2,057,000 gas

Completed


COMPLETED

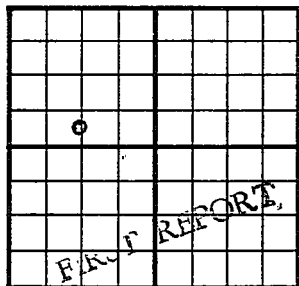County Seward State KansasSec. 5 (Blk. Twp.) 35 (Sur. Rge.) 34W Map No.Operator Plains NaturalWell No. 3 Farm DowdyElev. 2936 Location C S $\frac{1}{2}$ S $\frac{1}{2}$ NW2440 Ft. From N Line NW1320 Ft. From W Line Quarter1st. Report OCT 11 1950

Completion

Remarks

Spudding Date 10-8-50Drlg. Data Hugoton Pool10" @ 643 WOC

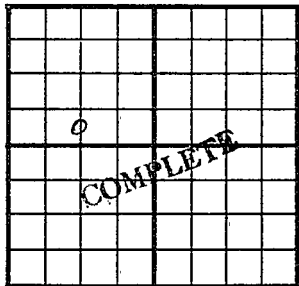County Seward State KansasSec. 5 (Blk. Twp.) 35 (Sur. Rge.) 34W Map No.Operator Plains NaturalWell No. 3 Farm DowdyElev. 2936 Location C S $\frac{1}{2}$ S $\frac{1}{2}$ NW2440 Ft. From N Line NW1320 Ft. From W Line Quarter

1st. Report

Completion NOV 15 1950Remarks Hugoton PoolSpudding Date 10-8-50Drlg. Data Gas well TD 273810" @ 643 Hol. 2572 Her. 2633Krider 2665 TD 2738 7" @ 2734210/ 2696-2731 60/ 2667-77 120/ 2635-5513000 A Comp. 2,057,000 gas

J. E. TYRA