


Clark

KANSAS

SECTION 5 TOWNSHIP 35 RANGE 24W

WELL NO. #4 Theis

COMPANY Shell Oil Co.

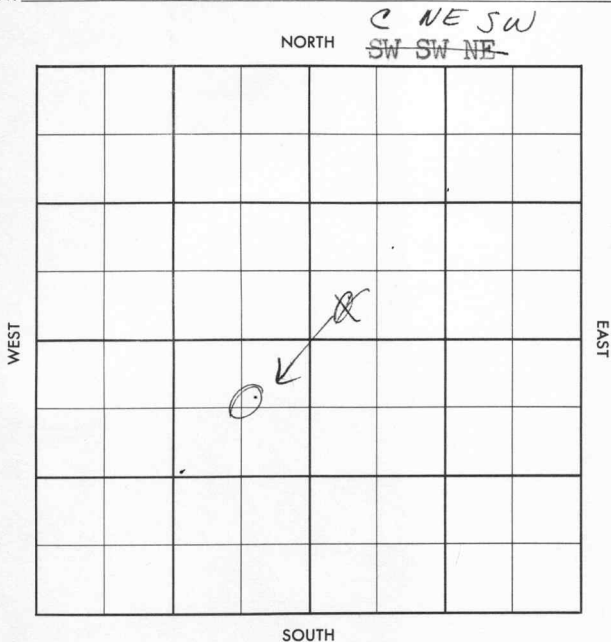

# WILDCAT

FORM 513 SUNRAY

County Clark Elev. \_\_\_\_\_  
 Sec. 5 Twp. 35 Rgs. 24W  
 Company Shell Oil Co.  
 Farm Name Theis No. 4

| TOPS   | DEPTH | LOG | DATUM | Loc. in Sec. |
|--------|-------|-----|-------|--------------|
| Anh.   |       |     |       | SW SW NE     |
| Tr.    |       |     |       |              |
| H.     |       |     |       |              |
| Tr.    |       |     |       |              |
| Dg.    |       |     |       |              |
| Bl.    |       |     |       |              |
| L.     |       |     |       | Geol.        |
| K.C.   |       |     |       | Contr.       |
| B.K.C. |       |     |       |              |
| Ce.    |       |     |       |              |
| C.     |       |     |       |              |
| M.     |       |     |       | Pool         |
| M.     |       |     |       | Wildcat      |
| K.     |       |     |       |              |
| Mz.    |       |     |       |              |
| Me.    |       |     |       |              |
| V.     |       |     |       |              |
| S.     |       |     |       |              |
| S.     |       |     |       |              |
| A.     |       |     |       |              |
| R.     |       |     |       |              |
| Pe.    |       |     |       |              |
| G.     |       |     |       |              |
| T.D.   |       |     |       |              |

|  |  |  |  |
|--|--|--|--|
|  |  |  |  |
|  |  |  |  |
|  |  |  |  |
|  |  |  |  |

Date Comm. \_\_\_\_\_  
 Location \_\_\_\_\_

24

# CORRECTION

FORM 513 SUNRAY

County Clark Elev. 1951 DF  
 Sec. 5 Twp. 35 Rge. 24W  
 Company Shell Oil Co.  
 Farm Name Theis No. 4

| TOPS                 | DEPTH       | LOG         | DATUM | Loc. in Sec.       |
|----------------------|-------------|-------------|-------|--------------------|
| Anh. <del>VLF9</del> |             |             |       | SW SW NE<br>CNE SW |
| Tp. <u>VLF9</u>      |             | <u>3406</u> |       |                    |
| H.                   |             | <u>4308</u> |       |                    |
| Tr.                  |             |             |       |                    |
| Dg.                  |             |             |       |                    |
| Bl.                  |             |             |       |                    |
| L.                   |             | <u>4504</u> |       |                    |
| K.C. <u>Marm</u>     |             | <u>5177</u> |       | Geol.              |
| B.K.C.               |             |             |       | Contr.             |
| Ce.                  |             | <u>5364</u> |       |                    |
| C.                   |             |             |       |                    |
| M. <u>14W</u>        |             | <u>5652</u> |       |                    |
| M. <u>chest</u>      |             | <u>5682</u> |       | Pool               |
| K.                   |             |             |       |                    |
| Mz. <u>ST GEN</u>    |             | <u>5998</u> |       | Wildcat            |
| Mo.                  |             |             |       |                    |
| V.                   |             |             |       |                    |
| S.                   |             |             |       |                    |
| S.                   |             |             |       |                    |
| A.                   |             |             |       |                    |
| R.                   |             |             |       |                    |
| Pe.                  |             |             |       |                    |
| G.                   |             |             |       |                    |
| T.D.                 | <u>6000</u> |             |       | ABANDONED          |

Date Comm.

Location APR 27 '57 APR 3 '57 APR 10 '57

4-5-57 24" @ 20' APR 17 '57  
16" @ 161/250 95/8 @ 615/625  
Ø 979 APR 24 '57 #3995 MAY 1 '57 Ø 5540  
MAY 8 '57 Ø ST 5646-5799 1hr run  
100' Ø Md VSGC @ FP 75-90  
BHP 300/30 Ø ST 5803-6000 1hr  
run 30' Ø Md N.S. FP 235-340  
BHP 470/36" Ø EA